

Map No.

KANSAS

Sec.

6

Twp.

20

R.

9W

Well No.

Christopher
Gypsy Oil

Farm

Company

NORTH

WEST

EAST

SOUTH

Location

Drilling Remarks

Rig Up

Drilling Remarks

RECORD

Cased _____ in. _____ ft.

Sand _____

Gas _____

Oil _____

Total Depth _____

PRODUCTION

1st 24 hrs. Nat. _____

1st 24 hrs. after shot _____

Gas _____ cu. ft.

Dry Hole _____

Abandoned _____

Rice

Map No. KANSAS Sec. 6 Twp. 20 R. 9W


Well No. 8-Christopher Farm
Gypsy Company

330 Ft. from N. Line

_____ Ft. from S. Line

_____ Ft. from E. Line

330 Ft. from W. Line

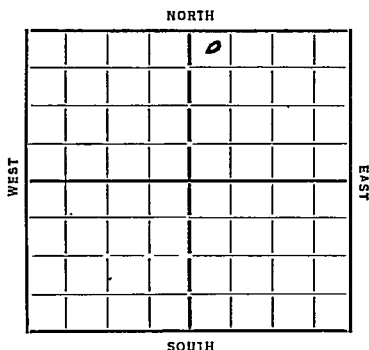

Date 1935

REPORT

3/20 Rot Rig
3/28 Rig
4/4 Kelly 2330 12" 202
4/11 Simpson 3227 8" 3227 Rust
4/18
4/26 Sil 3240 6" liner 3241
T 3245 2600' fluid 10 hrs
PB 18"
5/1 Sil 3240 T 3245
PB 3243 1/2
633 Sil
40 W.

COMPLETED

Map No. 49 Sec. 6 Twp. 20 R. 9WWell No. 8-ChristopherGypsy Oil Company

Contractor

FIRST REPORTS

330 Ft. from N. Line

Ft. from S. Line

Ft. from E. Line

330 Ft. from W. Line

SECTION PLAT

		0	

Location

Rig up

Drilling and Remarks:

Rot Rig

RECORD

Cased in., ft.

Sand

Gas

Oil

Total Depth

PRODUCTION

1st 24 hrs. Nat.

1st 24 hrs. after shot

Gas Cu. Ft.

Dry Hole

Abandoned

Date

ORVAL MANNSCHRECK

3-20-35 192

Scout

KANSAS

Map No. 49 Sec. 6 Twp. 20 R. 9WWell No. 8-ChristopherGypsy oil Company

Contractor

COMPLETED

SECTION PLAT

330 Ft. from N. Line

Ft. from S. Line

Ft. from E. Line

330 Ft. from W. Line

		0	

Location

Rig up

Drilling and Remarks:

P.B. 3243 1/2633 oil
40 W.

RECORD

Cased in, ft.

Sand Sil 3240

Gas

Oil

Total Depth 3245

PRODUCTION

1st 24 hrs. Nat.

1st 24 hrs. after shot

Gas Cu. Ft.

Dry Hole

Abandoned

Date

ORVAL MANUSCRIPT

5-1-35 192

Scout