

Rice

Map No. KANSAS Sec. 6 Twp. 20 R. 9W


Well No. 10-Christopher Farm
Gypsy Oil Company

_____ Ft. from N. Line

330 Ft. from S. Line

_____ Ft. from E. Line

990 Ft. from W. Line

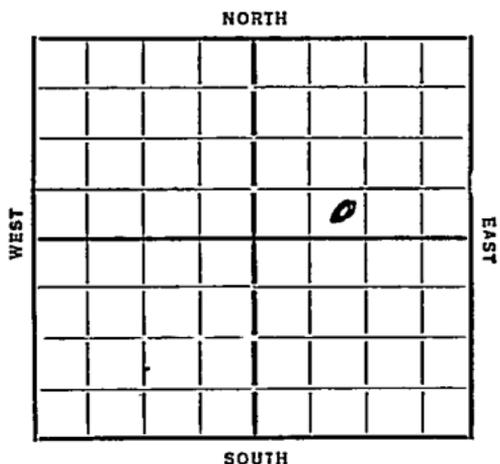

Date 1935 REPORT

3/13 Rgn

3/21 —

3/28 Dlg 2175 12" 205

4/4 8" 3235 T 7 3239 Reet

4/11 Siliceous 3258 T 7 3263
3000' oil

4/18 prep to pump.

4/26 testing

5/1 Sib 3258 T 7 3263
1068 Nat.

COMPLETED

Map No. 49 Sec. 6 Twp. 20 R. 9W

Well No. 10-Christopher

Contractor

FIRST REPORTS


..... Ft. from N. Line

330 Ft. from S. Line

..... Ft. from E. Line

990 Ft. from W. Line

SECTION PLAT

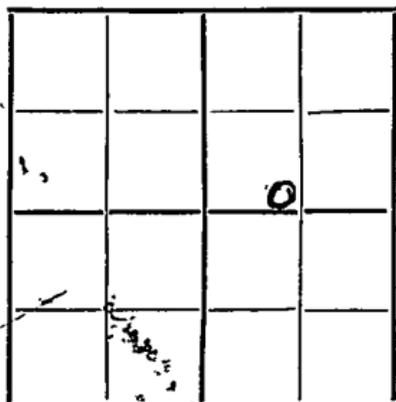

Location.....

Rig up.....

Drilling and Remarks:

Sign

RECORD

Cased..... in., ft.

Sand.....

Gas.....

Oil.....

Total Depth.....

PRODUCTION

1st 24 hrs. Nat.....

1st 24 hrs. after shot.....

Gas..... Cu. Ft.

Dry Hole.....

Abandoned.....

Date

3-13-35 192

ORVAE MANNSCHRECK

Scout

Map No. 49 Sec. 6 Twp. 20 R. 9W

Well No. 10-Christopher

kyssy oil

Company

Contractor

SECTION PLAT

COMPLETED

Ft. from N. Line

330 Ft. from S. Line

Ft. from E. Line

990 Ft. from W. Line

		0	

Location

Rig up

Drilling and Remarks:

1068 nat

RECORD

Cased in., ft.

Sand oil 3258

Gas

Oil

Total Depth 3263

PRODUCTION

1st 24 hrs. Nat.

1st 24 hrs. after shot

Gas Cu. Ft.

Dry Hole

Abandoned

Date

5-1-35 192

ORVAL MANNSCHECK

Scout