


Rice

Map No. KANSAS Sec. 6 Twp. 20 R. 9W

Well No. 11-Christopher Farm
Gypsy Oil Company

_____ Ft. from N. Line
330 Ft. from S. Line
330 Ft. from E. Line
_____ Ft. from W. Line

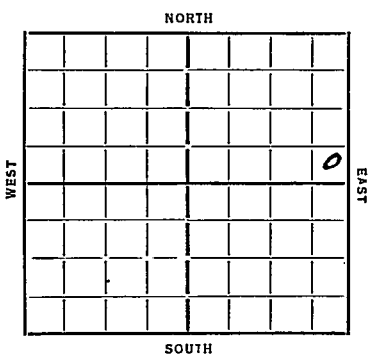

Date

REPORT

5/8 Rig Rot.
5/16 ddy 1575 12" 204
5/23 " 3115
5/29 " 3231 878 3231
6/6 Oil 3248 T7 3254
669 Bbls 1000 acid
6/12 Oil 3248 T7 3254
1000 acid
898 Bbls Oil
14 " Water

COMPLETED

Map No. 49 Sec. 6 Twp. 20 R. 9W

Well No. 11-Christopher

Happy oil

Company

Contractor

FIRST REPORTS SECTION PLAT

..... Ft. from N. Line

330 Ft. from S. Line

330 Ft. from E. Line

..... Ft. from W. Line

			0

Location.....

Rig up.....

Drilling and Remarks:

Rig Rot

RECORD

Cased..... in., ft.

Sand.....

Gas.....

Oil.....

Total Depth.....

PRODUCTION

1st 24 hrs. Nat.....

1st 24 hrs. after shot.....

Gas..... Cu. Ft.

Dry Hole.....

Abandoned.....

Date

5-8-35

192

ORVAL MANSCHRECK

Scout

Map No. 49 Sec. 6 Twp. 20 R. 9W

Well No. 11-Christopher

Myers oil Company

Contractor

(Stamp: RECORDED)

SECTION PLAT

			0

.....Ft. from N. Line

330 Ft. from S. Line

330 Ft. from E. Line

.....Ft. from W. Line

Location.....

Rig up.....

Drilling and Remarks:

1000 acid

898 oil

14 Water

RECORD

Cased.....in.,.....ft.

~~Sand~~ Sil 3248

Gas.....

Oil.....

Total Depth. 3254

PRODUCTION

1st 24 hrs. Nat.....

1st 24 hrs. after shot.....

Gas.....Cu. Ft.

Dry Hole.....

Abandoned.....

Date

6-12-35 192.....

(Stamp: ORIGINAL MANUSCRIPT) Scout