


Section 6 Township 20 Range 9W
 Well No. 9 Hilgers
 Company Ramsey Pet.

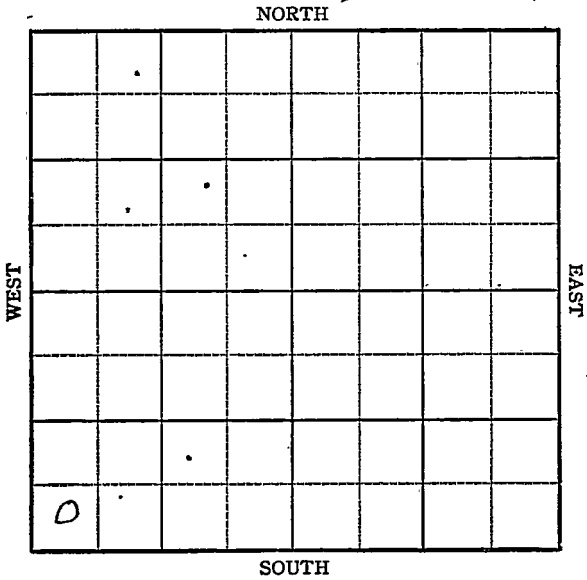

Sec. 6 Twp. 20 R. 9-W

Well No. #6 ~~#1~~ Hilgers Farm

Ramsey Pet Company

Chase Pool


 Ft. from N. Line

330 Ft. from S. Line

 Ft. from E. Line

330 Ft. from W. Line

SW/C

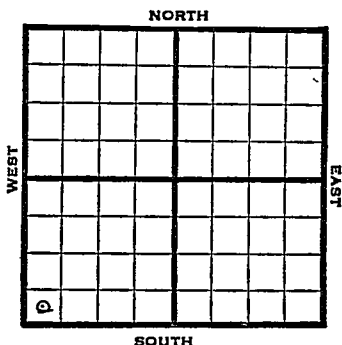

1948

E11 1741'

R E P O R T

8/11

8" @ 238'

8/18

Drlg 3080'

Simpson 3269'

Arbuckle 3273' - 76'

TD 3276'

5" @ 3269'

8/25

Arb. 3273'

5" @ 3269'

TD 3276'

Pump 100' oil Pot

42° Gr.

Comp

COMPLETED

Rice County Kansas State

Map No. _____ Sec. 6 Twp. 20 R. 9W

Well No. 1 Hilgers

Ramsey Pet. Company

FIRST REPORT

Contractor

SW/C

SECTION PLAT

_____ Ft. from N. Line


330

_____ Ft. from S. Line

_____ Ft. from E. Line

330

_____ Ft. from W. Line

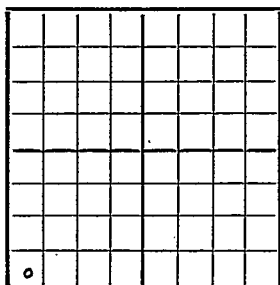

Chase Pool

Remarks:

8" @ 238 drlg. 3080

Date
AUG 11 1948

Scout
S. J. LEWIS

Rice County Kansas State

Map No. 49 Sec. 6 Twp. 20 R. 9W

Well No. 6 Hilgers

Ramsey Pet. Company

CORRECTION Contractor

SW/C

SECTION PLAT

o							

 Ft. from N. Line

330 Ft. from S. Line

 Ft. from E. Line

330 Ft. from W. Line

Chase Pool

Remarks:

Reported as #1 Hilgers

Date
AUG 18 1948

Scout

S. J. LEWIS

State

P 9W

Well No. 6 Hilgers

Company

Contractor

E1.1741

SECTION PLAT

Ft. from N. Line

Ft. from S. Line

Ft. from E. Line

Ft. from W. Line

Chase Pool

Remarks:

Es. 7^o 2^o

5'03269

7753276

Pump 1000il Oil

42 = Gu

Date _____

Scout

S. J. LEWIS

AUG 25 1948