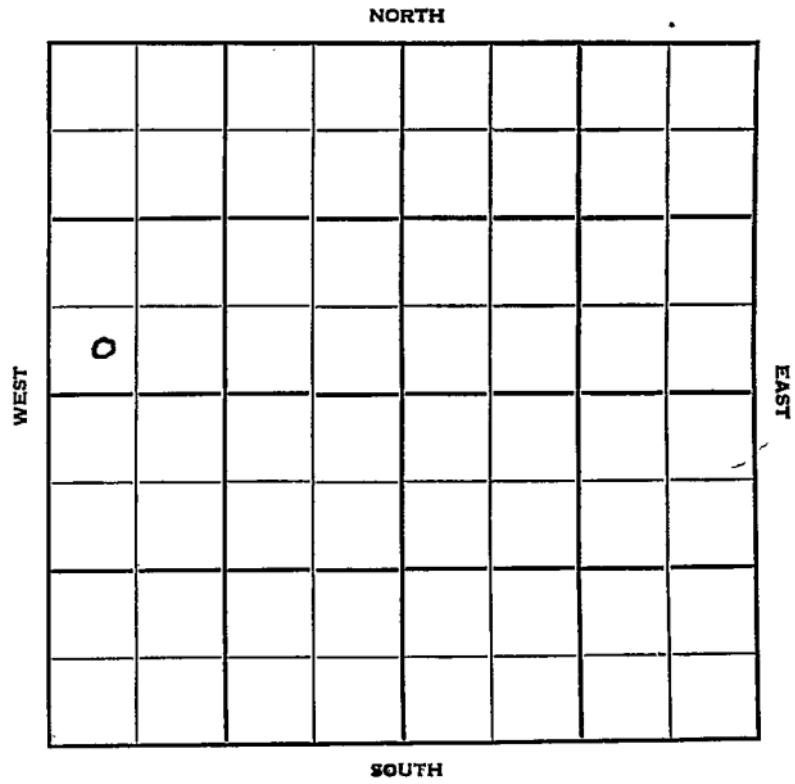


Section 6 Township 20 Range 9-W
Well No. #3-B #9 Christopher
Company Hall & Branine

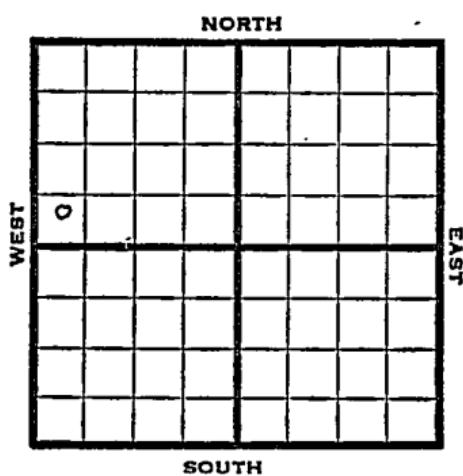


KANSAS Rice

Sec. 6 Twp. 20 R. 9-W
 Well No. 3-B Christopher Farm
Hall & Branine Company

Atlas Contractor
 Chase

Ft. from N. Line

455 Ft. from S. Line

Ft. from E. Line

330 Ft. from W. Line

SW SW NW

Twin

1950	Elev 1739	REPORT
------	-----------	--------

11/1 Spud 10-30-50

Drilg

11/29 8" @ 158

Arb 3270-78

5" @ 3271

FU 2700' oil in hole

Comp 50 bopd TD 3278

Completed

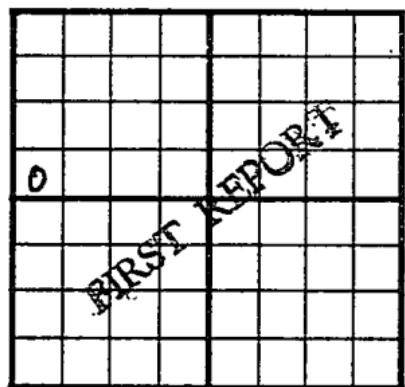
COMPLETED

County Rice State Kansas
 Sec. 6 (Blk.) 20 (Sur. Rge.) 9W Map No.

Operator Hall & Branine

Well No. 9 Farm Christopher (twin well)

Elev. 1739 Location SW SW NW



455 Ft. From S Line NW

330 Ft. From W Line Quarter

1st. Report NOV 1 1950

Completion

Remarks

Atlas - Contr.

Spudding Date 10-30-50

Drlg. Data

Chase Pool

drlg.

J. E. TYRA

Kansas

Map No. _____ Sec. 6 Twp. 20 R. 9W

Well No. 3-B Christopher

Hall & Branine Company

CORRECTION

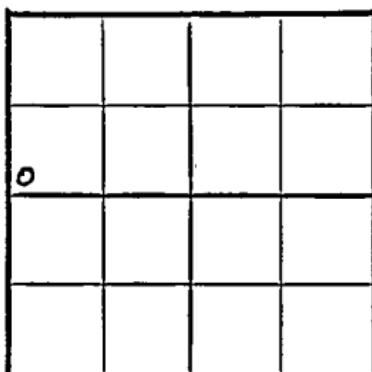
Contractor

SW SW NW

> NOV 15 1950

SECTION PLAT

____ Ft. from N. Line
 455 " " Ft. from S. Line
 _____ Ft. from E. Line
 330 Ft. from W. Line

Rice County

Location _____

RECORD

Rig up _____

Cased in. ft.

Drilling and Remarks:

Sand _____

Reported

Gas _____

#9 Christopher

Oil _____

Total Depth _____

PRODUCTION

1st 24 hrs. Nat. _____

1st 24 hrs. after shot _____

Gas Cu. Ft. _____

Dry Hole _____

Abandoned _____

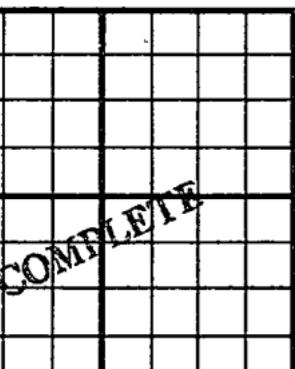
Date

NOV 15 1950

19

J. E. TYRDA

Scout

County	Rice	State	Kansas				
Sec.	6	(Blk. Twp.)	20	(Sur. Rge.)	9W	Map No.	
Operator	Hall & Branine						
Well No.	3-B	Farm	Christopher				
Elev.	1739	Location	SW SW NW				
			455 Ft. From	S	Line	NW	
			330 Ft. From	W	Line	Quarter	
1st. Report							
Completion NOV 29 1950							
Remarks Chase Pool							
Atlas - Contr.							
Spudding Date 10-30-50							
Drg. Data	Oil well		TD 3278				
8" @ 158	Arb. 3270-78		TD 5" @ 3271				
FU 2700'	oil in hole		Comp. 50 bopd				

J. E. TYRA