

McPherson


Form 51-5M-2-29-34703

Map No. KANSAS Sec. 6 Twp. 20 R. 12W

Well No. 1- Miller "B" Farm

Lario & Shell Company

NORTH

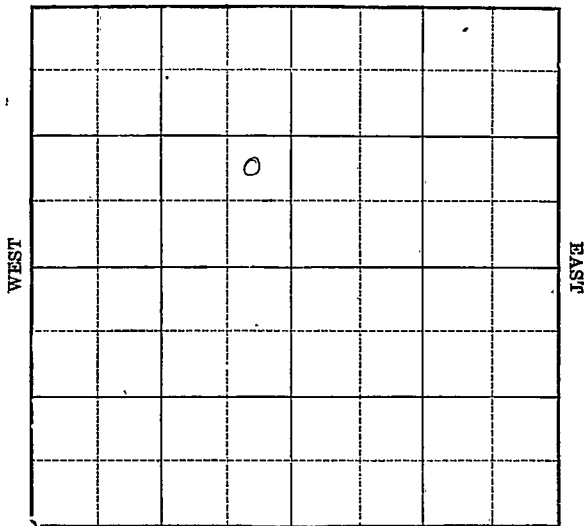

SOUTH

Location \_\_\_\_\_

Drilling Remarks \_\_\_\_\_

\_\_\_\_\_

\_\_\_\_\_

RECORD

Cased \_\_\_\_\_ in. \_\_\_\_\_ ft.

Sand \_\_\_\_\_

Gas \_\_\_\_\_

Oil \_\_\_\_\_

Total Depth \_\_\_\_\_

Rig Up \_\_\_\_\_

Drilling Remarks \_\_\_\_\_

\_\_\_\_\_

\_\_\_\_\_

PRODUCTION

1st 24 hrs. Nat. \_\_\_\_\_

1st 24 hrs. after shot \_\_\_\_\_

Gas \_\_\_\_\_ cu. ft.

Dry Hole \_\_\_\_\_

Abandoned \_\_\_\_\_

M<sup>c</sup>Pherson

FORM 252A-5M-8-30-PETROL

Map No. KANSAS Sec. 6 Twp. 20 R. 1<sup>w</sup>

Well No. 1-Miller "B" Farm

Lario & Sheel Company


\_\_\_\_\_ Ft. from N. Line

990 Ft. from S. Line

330 Ft. from E. Line

\_\_\_\_\_ Ft. from W. Line

1931

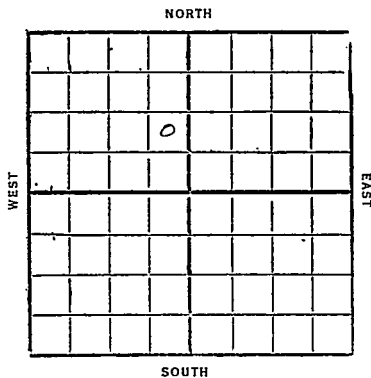

Date	REPORT
4/29	Loc
5/6	Big
5/13	Big & tools
5/20	Spdg 235'
5/27	15"-569
	Drlg 1270'
6/3	Cwedge 12"-1405'
6/10	12"-1402
	Drlg 1990'
6/17	10"-2263
	Drlg 2330'
6/24	8"-2590
	Drlg 2860'
7/11	Top Chat 2957
	small show oil & gas
	2975-83
	Drlg 3010'
7/8	AZW 3025'
	T.P. 3125' Wre 8"
7/15	Viola <del>3475</del> 3418
	2900' oil in hole

(over)

7/22- Top Viola 3418 (SLM)  
TD 3428  
shot 20 qt 3418-26  
swab 112 1/2 bbl per hr  
for first 5 hrs

7/29- Cased 6"-3399  
Viola 3418-28  
TD 3428'  
shot 20 qt 3418-26  
2150 bbl oil  
potential  
Comp.

*McPherson*

Map No. **KANSAS** Sec. *6* Twp. *20* R. *1*  
 Well No. *1* *Miller "B"*  
*Lario & Shell* Company

Contractor

**FIRST REPORTS**

**SECTION PLAT**

..... Ft. from N. Line  
*990* Ft. from S. Line  
*330* Ft. from E. Line  
 ..... Ft. from W. Line

	0		

Location..... ✓  
 Rig up.....  
 Drilling and Remarks:

**RECORD**

Cased..... in., ..... ft.  
 Sand.....  
 Gas.....  
 Oil.....  
 Total Depth.....

**PRODUCTION**

1st 24 hrs. Nat.....  
 1st 24 hrs. after shot.....  
 Gas..... Cu. Ft.  
 Dry Hole.....  
 Abandoned.....

Date

APR 29 1931

**CHAS. L. SHERWOOD**

*McPherson*

Map No. KANSAS Sec. 6 Twp. 20 R. 1 <sup>W</sup>

Well No. 43 1 *Miller "B"*

*Lario & Sheel* Company

Contractor

**COMPI**

**SECTION PLAT**

.....Ft. from N. Line

990 Ft. from S. Line

330 Ft. from E. Line

.....Ft. from W. Line


Location.....

Rig up.....

Drilling and Remarks:

*20/3418-76*

*Potential 2150 lbs.*

**RECORD**

Cased 6" in., 3399 ft.

Sand Viola 3418-78

Gas.....

Oil.....

Total Depth 3478

**PRODUCTION**

1st 24 hrs. Nat.....

1st-24 hrs. after shot.....

Gas.....Cu. Ft.

Dry Hole.....

Abandoned.....

Date

**JUL 29 1931**

**CHAS. L. SHERWOOD**