


Section 6 Township 20 Range 9-W

Well Number #4-Hilton "A"

Company Ramsey

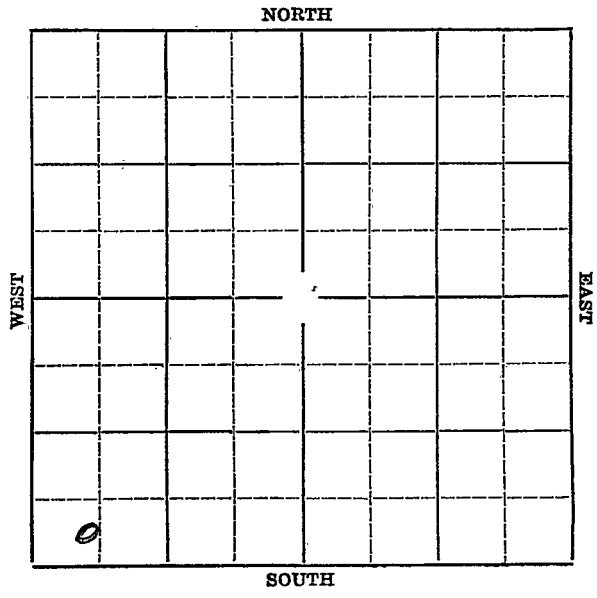

KANSAS

Map No. 49 Sec. 6 Twp. 20 R. 9WWell No. 4 Hilton "A"Ramsey CompanyJ Contractor

SECTION PLAT

0			

 Ft. from N. Line330 Ft. from S. Line Ft. from E. Line617 Ft. from W. Line

FIRST REPORT

Location Rig up

Drilling and Remarks:

Spud.

RECORD

Cased in., ft.Sand Gas Oil Total Depth

PRODUCTION

1st 24 hrs. Nat. 1st 24 hrs. after shot Gas Cu. Ft.Dry Hole Abandoned

Date

19S. J. LEWIS Scout

Map No. 49 Sec. 6 Twp. 20 R. 9W

Well No. 4 Hilton A

Ramsey Company

J Contractor

SECTION PLAT

 Ft. from N. Line

330 Ft. from S. Line

 Ft. from E. Line

617 Ft. from W. Line

COMPLETED

Location

Rig up

Drilling and Remarks:

Si 63293

PD 918 Nat.

RECORD

Cased in., ft.

Sand

Gas

Oil

Total Depth 3297

PRODUCTION

1st 24 hrs. Nat.

1st 24 hrs. after shot

Gas Cu. Ft.

Dry Hole

Abandoned

Date

Oct 7 1936₁₉

S. J. LEWIS Scout