


Section 7 Township 20 Range 9-W


Well No. #1 - Wickerham

Company Gulf
Saco Oil

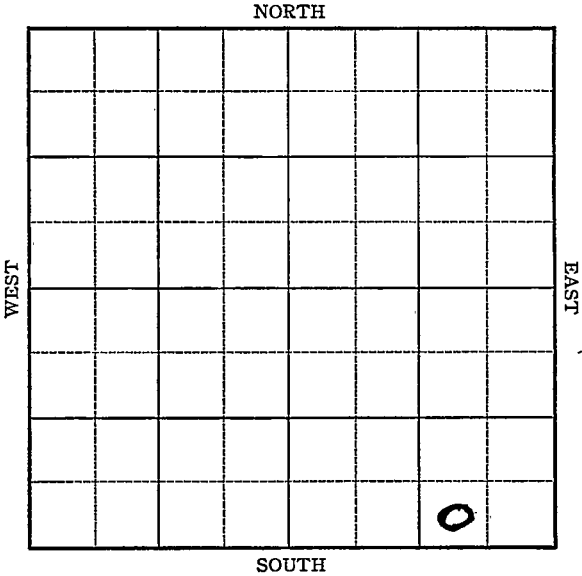

Sec. 7 Twp. 20 R. 9-WWell No. #2 Wickerham #1 Farm~~Saco Oil~~ Gulf Company Ft. from N. Line330 Ft. from S. Line990 Ft. from E. Line Ft. from W. Line

Elev. 1761

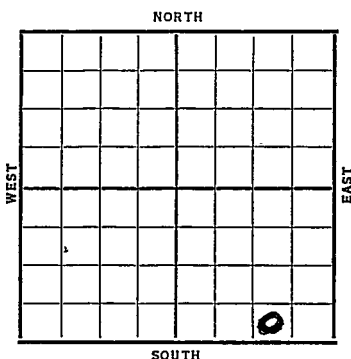

Date	REPORT	O. W. D. D
1937		
8/4	Cellar	
8/13	R. U. R.	
8/20	10" @ 187'. Drlg. 1765'.	
8/28	Topeka 2575'. Drlg. 2650'.	
9/3	Drlg. 3332'.	
9/8	Sil. 3308'.	
	T.D. 3339'. D & A.	
	ABANDONED	
1939		O. W. D. D
10/11	7" - 3459'	
	T.D. 3460' WOC.	
	Gulf taking over. S.W.D.	
10/19	" " " " "	
10/26	TD 3839' SD.	
11/2	1000 acid.	
11/9	Run 3" tubing.	
		OVER

1939

11/16 TD 3839'
Run 3" tubing.

11/23 " " "

11/29 " " "

12/7 " " "

12/13 T.D. 3839'
1000 acid.
Salt water disposal well.

ABANDONED

Rice **KANSAS**Map No. _____ Sec. 7 Twp. 20 R. 9 WWell No. 2 - WickerhamSacco Oil Company

Contractor _____

FIRST REPORT**SECTION PLAT**

			0

_____ Ft. from N. Line

330 Ft. from S. Line990 Ft. from E. Line

_____ Ft. from W. Line

Location _____

Rig up _____

Drilling and Remarks:

Cellar**RECORD**

Cased _____ in., _____ ft.

Sand _____

Gas _____

Oil _____

Total Depth _____

PRODUCTION

1st 24 hrs. Nat. _____

1st 24 hrs. after shot _____

Gas _____ Cu. Ft.

Dry Hole _____

Abandoned _____

Date

AUG 4 - 1937₁₉H. D. Hatfield Scout

KANSAS

Map No. _____ Sec. 7 Twp. 20 R. 9WWell No. 2- WickerhamSanco oil Company

Contractor _____

ABANDONED

SECTION PLAT

			0

_____ Ft. from N. Line

330 Ft. from S. Line990 Ft. from E. Line

_____ Ft. from W. Line

Location _____

Rig up _____

Drilling and Remarks:

NO. 17

RECORD

Cased _____ in., _____ ft.

Sand 3308

Gas _____

Oil _____

Total Depth 3339

PRODUCTION

1st 24 hrs. Nat. _____

1st 24 hrs. after shot _____

Gas _____ Cu. Ft.

Dry Hole _____

Abandoned _____

Date

SEP 8 1937 19

H. D. Hatfield

Scout

Map No. 49 Sec. 7 Twp. 20 R. 9WWell No. 1 WickerhamGulf

Company

Contractor

FIRST REPORT

SW SE SE

 Ft. from N. Line330 Ft. from S. Line990 Ft. from E. Line Ft. from W. Line

CHASE POOL

SECTION PLAT

Location Rig up

Drilling and Remarks:

OWDD-

Was Saco #2;

Gulf taking over.

SWD

7" - 3459

T.D. 3460

WOC

RECORD

Cased in., ft.Sand Gas Oil Total Depth

PRODUCTION

1st 24 hrs. Nat. 1st 24 hrs. after shot Gas Cu. Ft.Dry Hole Abandoned

Date

19

19

S. J. LEWIS

Scout

Rice

KANSAS

Map No. 49 Sec. 7 Twp. 20 R. 9WWell No. 1 Wickerham

Gulf

Company

Contractor

ABANDONED

SW SE SE

SECTION PLAT

			0

_____ Ft. from N. Line

330 Ft. from S. Line990 Ft. from E. Line

_____ Ft. from W. Line

CHASE POOL

Location _____

Rig up _____

Drilling and Remarks: *1000 acid*

Salt Water
Disposal Well

RECORD

Cased _____ in., _____ ft.

Sand _____

Gas _____

Oil _____

Total Depth 3839

PRODUCTION

1st 24 hrs. Nat. _____

1st 24 hrs. after shot _____

Gas _____ Cu. Ft.

Dry Hole _____

Abandoned _____

Date

DEC. 13 1939 19

S. J. LEWIS Scout