


Map No. **KANSAS** Sec. **7** Twp. **20** R. **9^W**
 Well No. **2-Goote** Farm
Sacco Oil Company

NORTH

WEST

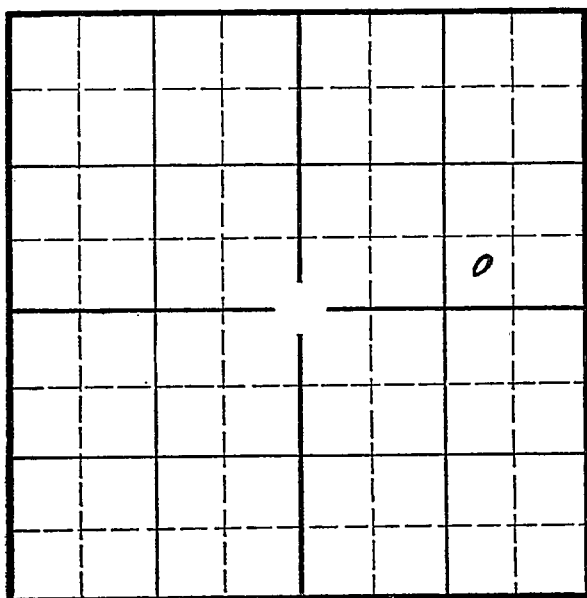

EAST

SOUTH

Location _____
 Drilling Remarks _____

Rig Up _____
 Drilling Remarks _____

RECORD

Cased _____ in. _____ ft.
 Sand _____
 Gas _____
 Oil _____
 Total Depth _____

PRODUCTION

1st 24 hrs. Nat. _____
 1st 24 hrs. after shot _____
 Gas _____ cu. ft. _____
 Dry Hole _____
 Abandoned _____

Map No. KANSAS Sec. 7 Twp. 20 R. 9W
Well No. 2 - Goot Farm
Sacco Oil Company


 Ft. from N. Line

330 Ft. from S. Line

990 Ft. from E. Line

 Ft. from W. Line

Elev. 1747

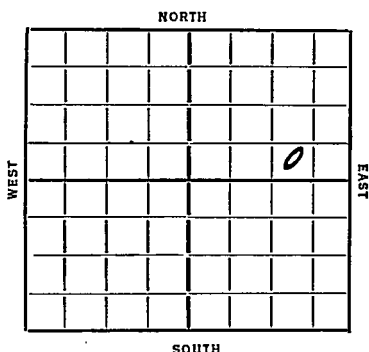

REPORT

<u>1/29</u>	<u>Material & Cellar</u>
<u>2/7</u>	<u>—</u>
<u>2/14</u>	<u>RR</u>
<u>2/21</u>	<u>Rgn</u>
<u>2/28</u>	<u>3/6-</u>
<u>3/13</u>	<u>Dlg 660 15" 156</u>
<u>3/20</u>	<u>12" 775 Drlg. 1255</u>
<u>3/27</u>	<u>10"- 1800' T.D. 1825 C.O.</u>
<u>4/2</u>	<u>10"- 1835' 8"- 2519' Drlg. 2530'</u>
<u>4/10</u>	<u>Drlg. 2710'</u>
<u>4/16</u>	<u>2717' U.R. 8".</u>
<u>4/23</u>	<u>K.C. 2940' S.O. 3028' Drlg. 3100'</u>
<u>4/30</u>	<u>6" @ 3266'. C.O. @ 3268'.</u>
<u>5/7</u>	<u>Sil. 3270'. Pay 3279-86'. T.D.</u>
	<u>Swab 13 bbls per hour.</u>
<u>5/13/36</u>	<u>Sil. 3270'.</u>
	<u>T.D. 3286'.</u>
	<u>3000 acid.</u>
	<u>736 ~~acid~~ bbls oil.</u>
	<u>COMPLETED</u>

Map No. 49 Sec. 7 Twp. 20 R. 9WWell No. 2- FooteSacco oil Company

Contractor

FIRST REPORTS

Ft. from N. Line

330 Ft. from S. Line990 Ft. from E. Line

Ft. from W. Line

SECTION PLAT

			0

Location

Rig up

Drilling and Remarks:

Material
✓
Clean

RECORD

Cased in., ft.

Sand

Gas

Oil

Total Depth

PRODUCTION

1st 24 hrs. Nat.

1st 24 hrs. after shot

Gas Cu. Ft.

Dry Hole

Abandoned

Date

ORVAL MANNSCHRECK

1-29-36 192

Scout

Map No. 49 Sec. 7 Twp. 20 R. 9W

Well No. 2 Foste

Bancroft Company

Contractor

SECTION PLAT

			0

 Ft. from N. Line

330 Ft. from S. Line

990 Ft. from E. Line

 Ft. from W. Line

COMPLETED

Location

Rig up

Drilling and Remarks:

Oil 3270

3000 acid

736 gals.

RECORD

Cased in., ft.

Sand

Gas

Oil

Total Depth 3286

PRODUCTION

1st 24 hrs. Nat.

1st 24 hrs. after shot

Gas Cu. Ft.

Dry Hole

Abandoned

Date

MAY 13 1936

S. J. LEWIS Scout