


Section 7 Township 20 Range 9-W

Well Number #3-Boote

Company Sacco Oil

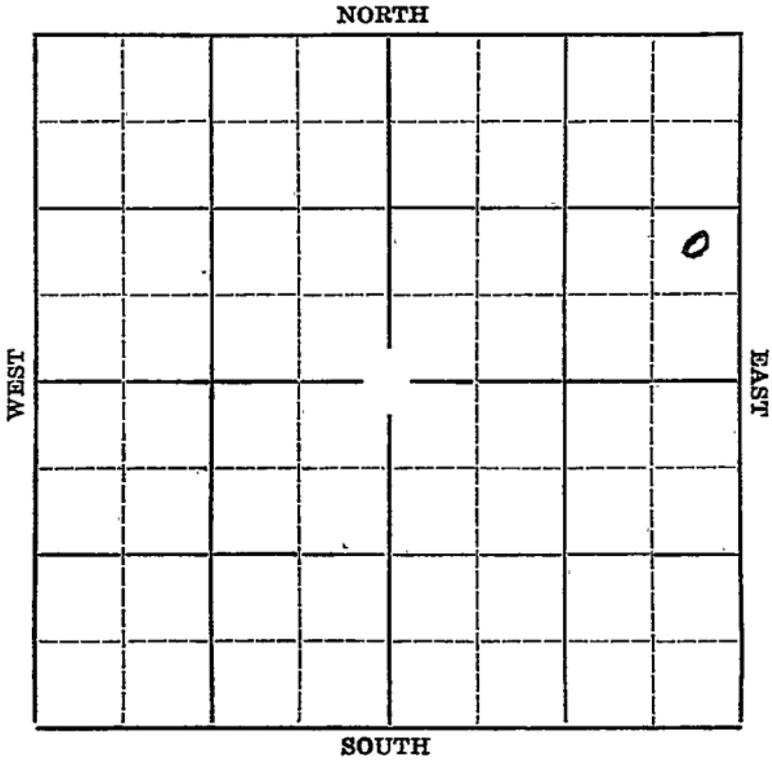

Map No. KANSAS Sec. 7 Twp. 20 R. 9W

Well No. #3 Foote Farm
Sacco Oil. Company


_____ Ft. from N. Line

990' Ft. from S. Line

330' Ft. from E. Line

_____ Ft. from W. Line

Elev. 1742

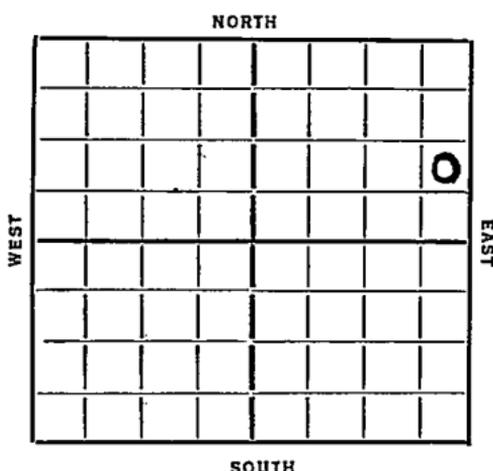

~~1936~~

REPORT

8/12 Machine.

8/20 15" @ 240'. 12½" @ 830'. Drlg. 950'

8/27 Drlg. 1522'.

9/3 Drlg. 1815'. 10" @ 1805'

9/10 Drlg. 2110'.

9/18 Drlg. 2370'.

9/24 Drlg. 2670'. 8" @ 2408'.

10/1 Drlg. 2687'.

10/8 8" @ 2743'. Drlg. 3070'.

10/15 Sil. 3271'. Set 7". T.D. 3273'.
Clean out.

10/22-T.D. 3289'. 2000 gallons of acid.
No test.

10/28/36-Sil. 3271'.
T.D. 3289'.
2000 gallons of acid.
Potential 479 bbls of oil.

COMPLETED

Price
Map No. 49 Sec. 7 Twp. 20 R. 9W

Well No. 3 Feet

Sacco Oil Company

Contractor

SECTION PLAT

			o

_____ Ft. from N. Line

990 Ft. from S. Line880 Ft. from E. Line

_____ Ft. from W. Line

FIRST REPORT

Location _____

Rig up _____

Drilling and Remarks:

Mach.

RECORD

Cased _____ in., _____ ft.

Sand _____

Gas _____

Oil _____

Total Depth _____

PRODUCTION

1st 24 hrs. Nat. _____

1st 24 hrs. after shot _____

Gas _____ Cu. Ft.

Dry Hole _____

Abandoned _____

Date

AUG 12 1938
19

S. J. LEWIS Scout

KANSAS

Form 26-1M Bks.—2-29

Map No. 49 Sec. 7 Twp. 20 R. 9W

Well No. 3 Foote

Bacco Oil Company

Contractor

SECTION PLAT

			o

_____ Ft. from N. Line

990 Ft. from S. Line

830 Ft. from E. Line

_____ Ft. from W. Line

COMPLETED

Location _____

Rig up _____

Drilling and Remarks:

Sil 0271
2000 acid
Pa 479

RECORD

Cased _____ in., _____ ft.

Sand _____

Gas _____

Oil _____

Total Depth 3289

PRODUCTION

1st 24 hrs. Nat. _____

1st 24 hrs. after shot _____

Gas _____ Cu. Ft.

Dry Hole _____

Abandoned _____

Date

OCT 28 1936₁₉

S. J. LEWIS Scout