


Map No. **KANSAS** Sec. **7** Twp. **20** R. **9-W**

Well No. **#3 Foote** Farm _____
Continental Oil Company

NORTH

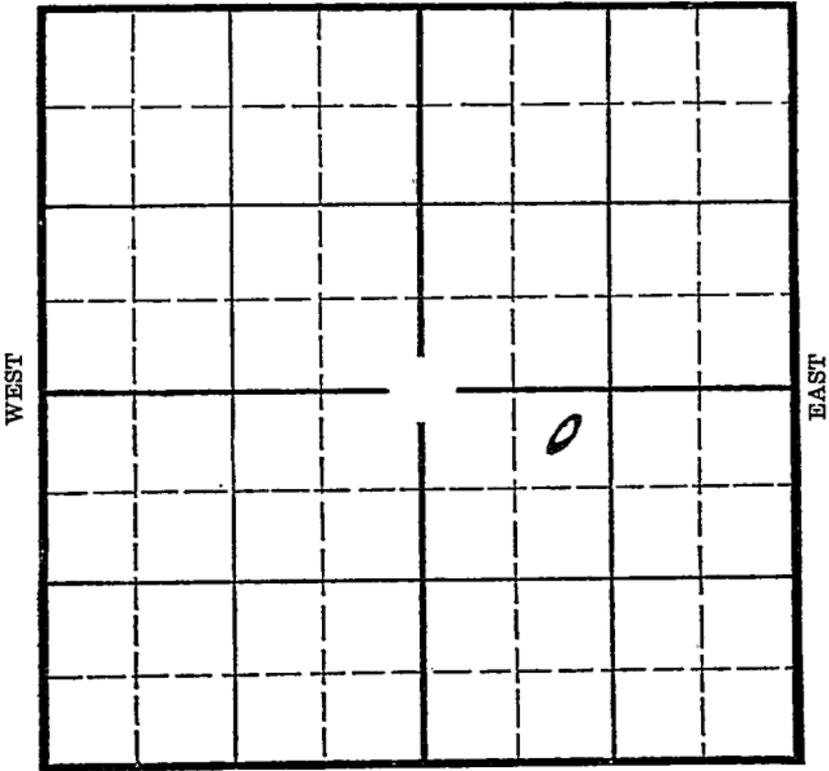

SOUTH

Location _____

Drilling Remarks _____

Rig Up _____

Drilling Remarks _____

RECORD

Cased _____ in. _____ ft.

Sand _____

Gas _____

Oil _____

Total Depth _____

PRODUCTION

1st 24 hrs. Nat. _____

1st 24 hrs. after shot _____

Gas _____ cu. ft. _____

Dry Hole _____


Abandoned _____

Rice

Map No. Sec. 7 Twp. 20 R. 9W

Well No. 3- Foote Farm
Continental Oil Company

330 Ft. from N. Line
 Ft. from S. Line
 Ft. from E. Line
990 Ft. from W. Line

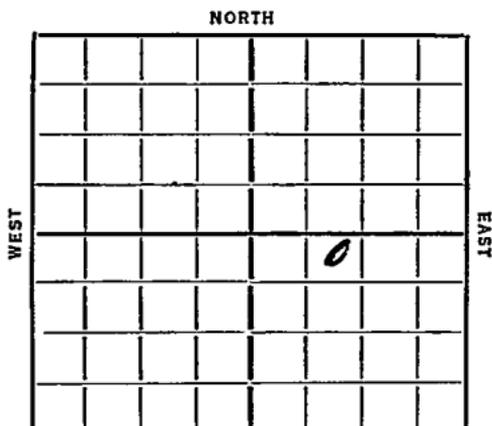

Elev. 1753

REPORT

DATE	REPORT
<u>2/12</u>	<u>Cellar</u>
<u>2/21</u>	<u> </u>
<u>2/28</u>	<u>Rot Rig</u>
<u>3/6</u>	<u> </u>
<u>3/13</u>	<u>Dlg 1682 18" 179</u>
<u>3/20</u>	<u>Drlg. 3118</u>
<u>3/27</u>	<u>T.Sil. 3270 5"- 3270 WOC</u>
<u>4/2</u>	<u>Pay 3293-96' T.D. 3298' 2500' oil</u> <u>Cleaning out.</u>
<u>4/10</u>	<u>Run tubing.</u>
<u>4/15</u>	<u>Sil 3270</u> <u>TD 3298</u> <u>4000 acid</u> <u>301 oil</u>

COMPLETED

KANSAS

Map No. 49 Sec. 7 Twp. 20 R. 9W

Well No. 3-900te
Continental oil Company

Contractor

FIRST REPORTS

SECTION PLAT

330 Ft. from N. Line
 Ft. from S. Line
 Ft. from E. Line
990 Ft. from W. Line

		0	

Location.....
 Rig up.....
 Drilling and Remarks:

cellar

RECORD

Cased..... in., ft.
 Sand.....
 Gas.....
 Oil.....
 Total Depth.....

PRODUCTION

1st 24 hrs. Nat.....
 1st 24 hrs. after shot.....
 Gas..... Cu. Ft.
 Dry Hole.....
 Abandoned.....

Date

2-12-36 192.....

ORVAL MANNSCHRECK
 Scout

Map No. 49 Sec. 7 Twp. 20 R. 9W

Well No. 3 Foote

Continental Company

Contractor

SECTION PLAT

330 Ft. from N. Line

..... Ft. from S. Line

..... Ft. from E. Line

590 Ft. from W. Line

		o	

COMPLETED

Location.....

Rig up.....

Drilling and Remarks:

Dil 3270
4000 acid
301 Dil

RECORD

Cased..... in., ft.

Sand.....

Gas.....

Oil.....

Total Depth... 3298

PRODUCTION

1st 24 hrs. Nat.....

1st 24 hrs. after shot.....

Gas..... Cu. Ft.

Dry Hole.....

Abandoned.....

Date

APR 15 1938 192

S. L. T. O Scout