


Rice

Form 51-5M-5-34-Palace

Map No. **KANSAS** Sec. 7 Twp. 20 R. 9^W

Well No. 3 McFarland Farm
Lario Oil Company

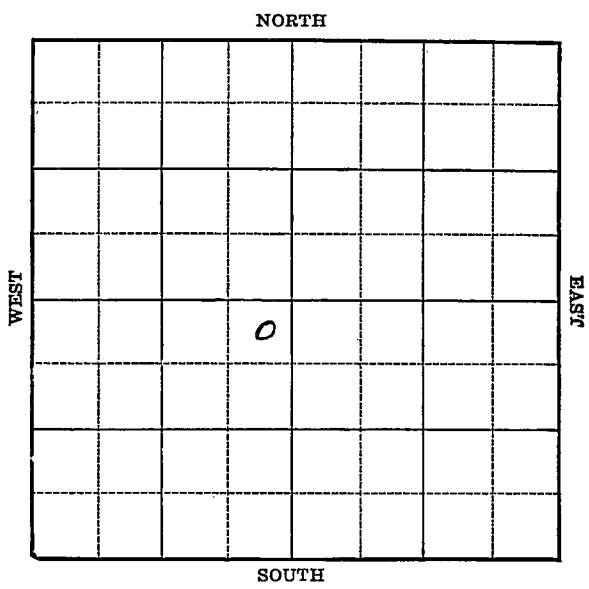

Location _____
Drilling Remarks _____

Rig Up _____
Drilling Remarks _____

RECORD

Cased _____ in. _____ ft.
Sand _____
Gas _____
Oil _____
Total Depth _____

PRODUCTION

1st 24 hrs. Nat. _____
1st 24 hrs. after shot _____
Gas _____ cu. ft.
Dry Hole _____
Abandoned _____

Rice

Map No. KANSAS Sec. 7 Twp. 20 R. 9^W


Well No. 3 Mc Garland Farm
Lario Oil Company

330 Ft. from N. Line

 Ft. from S. Line

330 Ft. from E. Line

 Ft. from W. Line

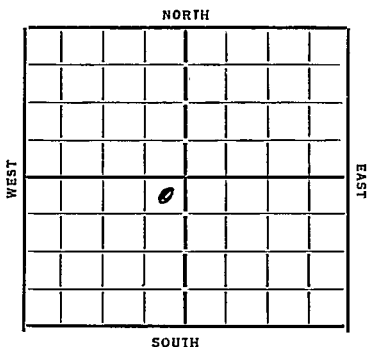

Date 1934

REPORT

7/18 Moving in
7/26 Bldg. Rg
8/2
8/9 Rgn up
8/16 Bldg 845
8/22 " 1455 12 1/2 1185
8/30 " 2140 24 7/8 1774 10" 1810
9/6 8" 2250 HFW 2515-25 UR 8"
9/13 Bldg 2545 8" 2545
9/20 Lancing 2948 S.O. 3020-28
6" 3160 Bldg 3226
9/27 Silicious lime 3264
T 3296 Shob 14 Bbls per hr.
10/4 1000 acid
10/11 — 10/18 — 10/22 —
11/1 — 11/8 — 11/15 — 11/22 —
11/27 Silicious 3264 T 3296
1000 acid Pump 170 Bbls.
16 hrs. 3% W.

COMPLETED

KANSAS

Map No. 49 Sec. 7 Twp. 20 R. 9NWell No. 3-McFarlandLario oil Company

Contractor

SECTION PLAT

	0		

330 ~~FEET~~ REPORT

Ft. from N. Line

Ft. from S. Line

330 Ft. from E. Line

Ft. from W. Line

Location

Rig up

Drilling and Remarks:

Moving in

RECORD

Cased _____ in., _____ ft.

Sand _____

Gas _____

Oil _____

Total Depth _____

PRODUCTION

1st 24 hrs. Nat. _____

1st 24 hrs. after shot _____

Gas _____ Cu. Ft.

Dry Hole _____

Abandoned _____

Date

7-18-34 19

ORVAL MANNSCHRECK

Scout

Map No. 49 Sec. 7 Twp. 20 R. 9W


Well No. 3-McFarland

Fariv et al Company

Contractor

COMPLETED

SECTION PLAT

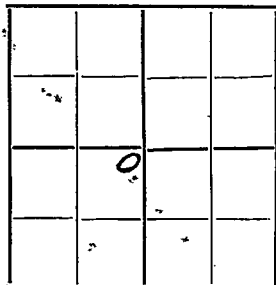

330 Ft. from N. Line

..... Ft. from S. Line

330 Ft. from E. Line

..... Ft. from W. Line

Location.....

Rig up.....

Drilling and Remarks:

1600 acid

pump 120 bbls
16 hrs. 30% w.

RECORD

Cased.....in., ...ft.

Sand siliceous 3264

Gas.....

Oil.....

Total Depth 3296

PRODUCTION

1st 24 hrs. Nat.....

1st 24 hrs. after shot.....

Gas.....Cu. Ft.

Dry Hole.....

Abandoned.....

Date

ORVAL MANNSCHRECK

11-27-34 192

Scout