

KANSAS


FORM 51 5M 6-46 PETROL

Rice County

Section' 7 Township 20 Range 9W

Well No. #3 McFarland

Company Joe Davis et al

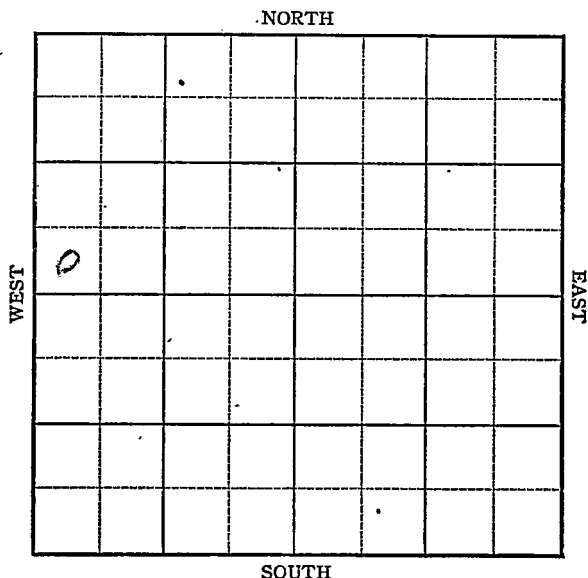

KANSAS

Sec. 7 Twp. 20 R. 9W

Well No. #3 McFarland Farm

Joe Davis et al

Company

Chase


Ft. from N. Line

330 Ft. from S. Line

Ft. from E. Line

330 Ft. from W. Line

SW NW

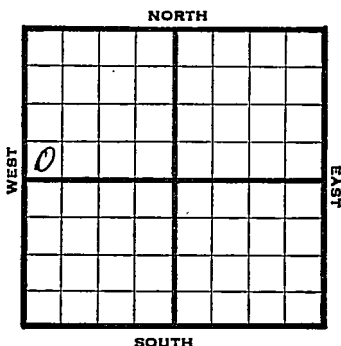

1946 1750 REPORT

7/10	Rig
7/16	"
7/23	20" @ 62'
	15" @ 347'
	Drlg 360'
7/30	13" @ 562,
	10" @ 870'
	Drlg 1210'
8/6	8" @ 1651
	1765 under digging
8/13	7" @ 1760'
	Drlg 2415'
8/20	" " "
8/27	7" @ 2260'
	Drlg 2410'
9/5	6" @ 2555'
	Drlg 2626'
9/10	6" @ 2667
	Drlg 2695'
9/18	Drlg 2807'
9/24	6" @ 2878
	Drlg 2975'
10/1	Lans 2956'
	6" @ 2966
	Drlg 2977'
10/8	5" @ 3009' CO
10/15	" "
10/22	3045 HR 5"

OVER

1946

10/29 5" @ 3033'
TD 3047'
11/6 Drlg 3076'
11/12 Arb 3264'
5" @ 3257'
TD 3267'
400' oil 3/4 hrs.
11/20 200' oil 3 hrs.
11/27 Arb 3264'
Pump 528 Pot
TD 3272'
42 Grav.

COMPLETED

KANSAS

Kansas Pool Name ChaseMap No. A9 Sec. 7 Twp. 20 R. 9WWell No. 3 McFarlandJoe Davis et al.


Company

FIRST REPORT

Contractor

SW NW

SECTION PLAT

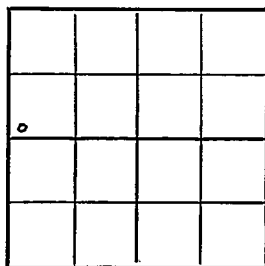

Ft. from N. Line

330 Ft. from S. Line

Ft. from E. Line

330 Ft. from W. LineRice County

Location

Rig up

Drilling and Remarks:

Rig.

RECORD

Cased _____ in., _____ ft.

Sand _____

Gas _____

Oil _____

Total Depth _____

PRODUCTION

1st 24 hrs. Nat. _____

1st 24 hrs. after shot _____

Gas _____ Cu. Ft.

Dry Hole _____

Abandoned _____

Date

JUL 10 1946 19S. J. LEWIS Scout

Map No. 49 Sec. 7 Twp. 20 R. 9W

Well No. 3 McFarland

Joe Davis etal. Company

COMPLETED

Contractor

SW NW


E1, 1950
SECTION PLAT

 Ft. from N. Line

330 Ft. from S. Line

 Ft. from E. Line

330 Ft. from W. Line

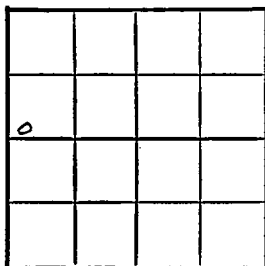

Rice County

Location

Rig up

Drilling and Remarks:

Art 326.4

Pump 525 Pst

42° Ge

RECORD

Cased in., ft.

Sand

Gas

Oil

Total Depth 3272

PRODUCTION

1st 24 hrs. Nat.

1st 24 hrs. after shot

Gas Cu. Ft.

Dry Hole

Abandoned

Date

NOV 27 1946

19

S. J. LEWIS

Scout