


Rice

KANSAS

Section 7 Township 20 Range 9-W

Well No. 3 Wickerham

Company Sacco Oil

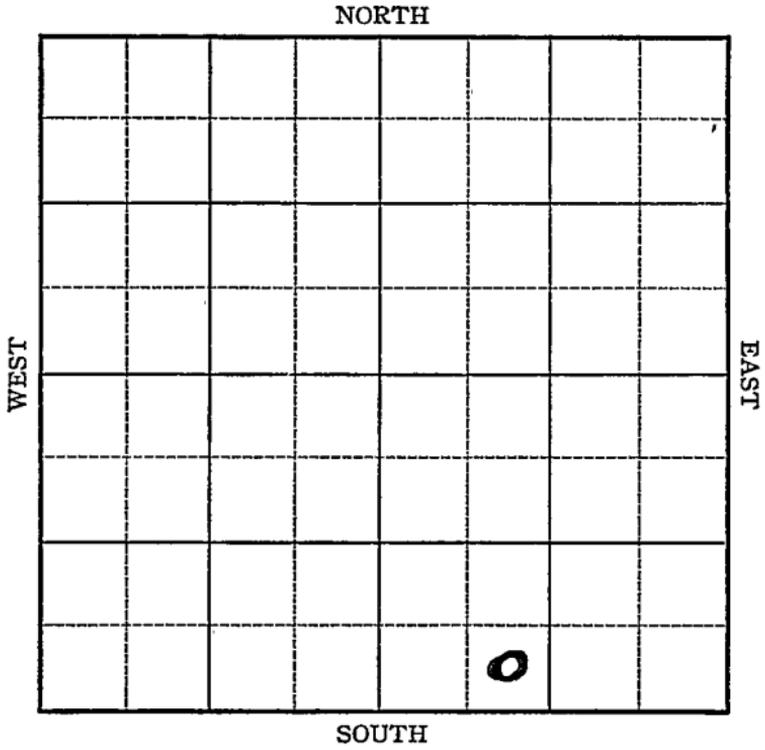

Sec. 7 Twp. 20 R. 9W

Well No. #3 Wickerham Farm


Sacco Oil Company

           Ft. from N. Line

330 Ft. from S. Line

           Ft. from E. Line

990 Ft. from W. Line

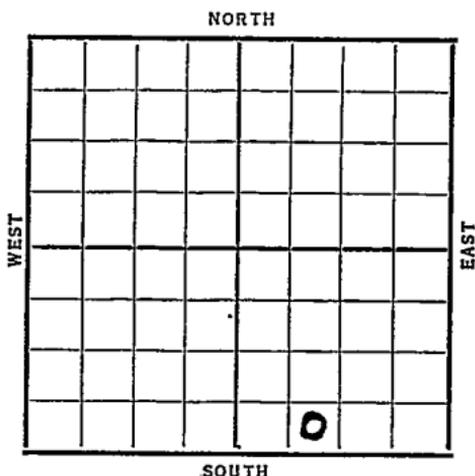

Date	REPORT
1937	
8/25	B.R.R.
9/3	R. R.
9/10	10" @ 187'. Drlg. 1800'.
9/17	Drlg. 2831'.
9/24	Sil. 3292'. T.D. 3303'.
	7" @ 3299'. RUST. No shows reported.
10/2	T.D. 3310'. Pumped 900 B.O.
	in 6 hrs.
10/6	7" @ 3299'.
	Sil. 3292'.
	T.D. 3310'.
	2000 acid.
	Potential 992 bbls.
	COMPLETED

*Pine* KANSAS

Map No. \_\_\_\_\_ Sec. 7 Twp. 20 R. 9W

Well No. 3 - Wickerham

Saco Oil Company

**FIRST REPORT**

Contractor \_\_\_\_\_

*se sw se*

\_\_\_\_\_ Ft. from N. Line

330 Ft. from S. Line

\_\_\_\_\_ Ft. from E. Line

990 Ft. from W. Line

**SECTION PLAT**

			0

Location \_\_\_\_\_

Rig up \_\_\_\_\_

Drilling and Remarks:

*BRP*

**RECORD**

Cased \_\_\_\_\_ in., \_\_\_\_\_ ft.

Sand \_\_\_\_\_

Gas \_\_\_\_\_

Oil \_\_\_\_\_

Total Depth \_\_\_\_\_

**PRODUCTION**

1st 24 hrs. Nat. \_\_\_\_\_

1st 24 hrs. after shot \_\_\_\_\_

Gas \_\_\_\_\_ Cu: Ft.

Dry Hole \_\_\_\_\_

Abandoned \_\_\_\_\_

Date

AUG 25 1937 19

H. D. Hatfield

Scout

Rice

KANSAS

Map No. 49 Sec. 8 Twp. 20 R. 9W

Well No. 3 Wickerham

Sacco Oil

Company

Contractor

**COMPLETED**

SE SW SE

11 Ft. from N. Line

330 Ft. from S. Line

\_\_\_\_\_ Ft. from E. Line

990 Ft. from W. Line

**SECTION PLAT**

			0

Location \_\_\_\_\_

Rig up \_\_\_\_\_

Drilling and Remarks:

2000 Acid

POT-992

**RECORD**

Cased 7 in., 3299 ft.

Sand 511 3292

Gas \_\_\_\_\_

Oil \_\_\_\_\_

Total Depth 3310

**PRODUCTION**

1st 24 hrs. Nat. \_\_\_\_\_

1st 24 hrs. after shot \_\_\_\_\_

Gas \_\_\_\_\_ Cu. Ft.

Dry Hole \_\_\_\_\_

Abandoned \_\_\_\_\_

Date

OCT - 6 1937

E. D. Hatfield

Scout