


Map No. KANSAS Sec. 7 Twp. 20 R. 9W
 Well No. 4-7 Goot Farm
Lewis Oil & Gas. Company

NORTH

WEST

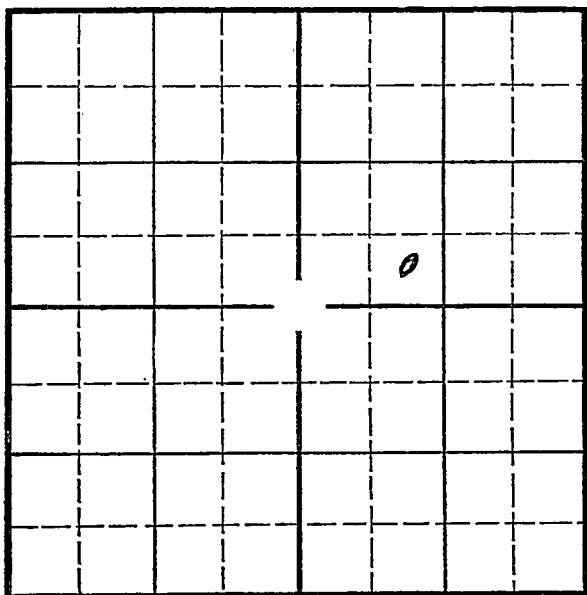

EAST

SOUTH

Location _____
 Drilling Remarks _____

Rig Up _____
 Drilling Remarks _____

RECORD

Cased _____ in. _____ ft.
 Sand _____
 Gas _____
 Oil _____
 Total Depth _____

PRODUCTION

1st 24 hrs. Nat. _____
 1st 24 hrs. after shot _____
 Gas _____ cu. ft. _____
 Dry Hole _____
 Abandoned _____

Map No. KANSAS Sec. 7 Twp. 20 R. 9W
Well No. 4-700 Farm Lario Oil & Gas Company


 Ft. from N. Line

330 Ft. from S. Line

 Ft. from E. Line

990 Ft. from W. Line

Elev. 1751

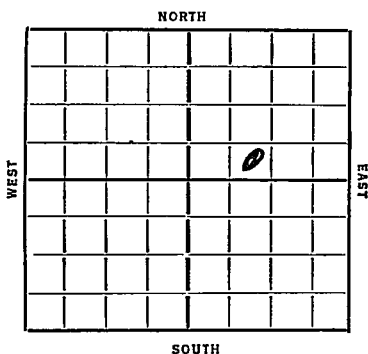

REPORT

1/29 Cellar
2/7 15" 160 WOC
2/14 dly 1978
2/21 " 3050 3250
2/28 7" 3251 Sil 3252 Rust
3/6 TD 3275 Sil 3250 (Cow)
Swabg 52 dip 12 hrs.
3/13 1000 acid
Get. 100 Bbls per day
Deepened to 3280
1000 acid
pumped 1000 Bbls Oil 20
hrs on pot
3/18 Sil 3254 TD 3280
1000 acid at 3275
Deepened to 3280 & 1000 acid
Pot 1116 Bbls.

COMPLETED

Map No. 49 Sec. 7 Twp. 20 R. 9WWell No. 4- FooteLario Oil & Gas Company

Contractor

FIRST REPORTS

SECTION PLAT

Ft. from N. Line

330 Ft. from S. Line

Ft. from E. Line

990 Ft. from W. Line

		o	

Location

Rig up

Drilling and Remarks:

Cellar

RECORD

Cased _____ in., _____ ft.

Sand _____

Gas _____

Oil _____

Total Depth _____

PRODUCTION

1st 24 hrs. Nat. _____

1st 24 hrs. after shot _____

Gas _____ Cu. Ft.

Dry Hole _____

Abandoned _____

Date

ORVAL MANNSCHRECK

1-29-36 192 _____ Scout

KANSAS

Map No. 49 Sec. 7 Twp. 20 R. 9W
Well No. 4-Foster

Lario Company

Contractor

COMPLETED

Ft. from N. Line

330 Ft. from S. Line

Ft. from E. Line

990 Ft. from W. Line

SECTION PLAT

		0	

Location

Rig up

Drilling and Remarks:

*1000 acid @ 3275
Deepened to 3280 +
1000 acid*

Pot 1116 hls

RECORD

Cased in, ft.

Sand Sil 3252

Gas

Oil

Total Depth 3280

PRODUCTION

1st 24 hrs. Nat.

1st 24 hrs. after shot

Gas Cu. Ft.

Dry Hole

Abandoned

Date

MAR 18 1936

ORVAL MANNSCHRECK

Scout