


Section 7 Township 20 Range 9-W

Well No. 4 Foote

Company Saco

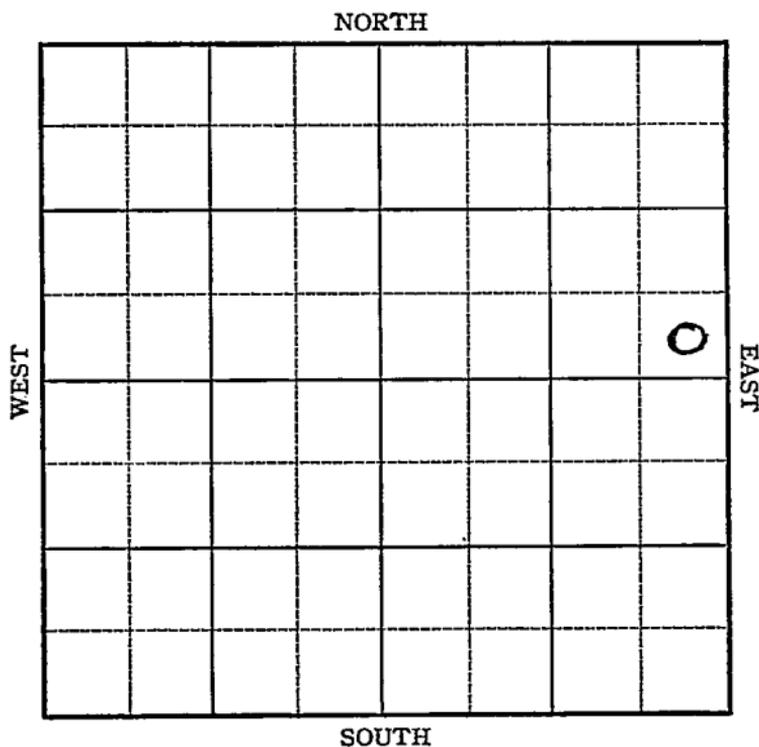

Sec. 7 Twp. 20 R. 9-W

Well No. #4 Foote Farm \_\_\_\_\_


Sago Company \_\_\_\_\_

\_\_\_\_\_ Ft. from N. Line

330 Ft. from S. Line

330 Ft. from E. Line

\_\_\_\_\_ Ft. from W. Line

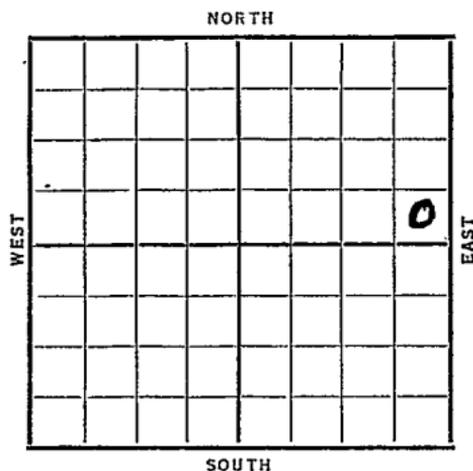

Elev. 1747'

Date	REPORT
1938	
1/5	Mat'l.
1/14	B. C. R.
1/20	Spud
1/28	15" - 160' 12"-795'
	Drlg. 1100
2/4	Drlg. 1785'
2/11	10" @ 1792'. Drlg. 2200'.
2/18	8" @ 2275'. T.D. 2550'.
	U. R. 8".
2/26	Drlg. 2790'.
3/4	8" @ 2517'. 6" @ 2964'.
	S.O. 3035-45'. Lans. 3060'.
	Drlg. 3200'.
3/11	Arb. 3276 & 5".
	T.D. 3277'. S.O. WOC.

OVER

1938

3/16

5" @ 3276'.

Arb. 3276'.

T.D. 3281'.

3000 acid.

Potential 677 bbls.

**COMPLETED**

Map No. 49 Sec. 7 Twp. 20 R. 9W

Well No. 4 Foote

Saco Company

Contractor

**FIRST REPORT**

SE NE

\_\_\_\_\_ Ft. from N. Line

330 Ft. from S. Line

330 Ft. from E. Line

\_\_\_\_\_ Ft. from W. Line

**SECTION PLAT**

			②

Location \_\_\_\_\_

Rig up \_\_\_\_\_

Drilling and Remarks:

**Matl**

**RECORD**

Cased \_\_\_\_\_ in., \_\_\_\_\_ ft.

Sand \_\_\_\_\_

Gas \_\_\_\_\_

Oil \_\_\_\_\_

Total Depth \_\_\_\_\_

**PRODUCTION**

1st 24 hrs. Nat. \_\_\_\_\_

1st 24 hrs. after shot \_\_\_\_\_

Gas \_\_\_\_\_ Cu. Ft.

Dry Hole \_\_\_\_\_

Abandoned \_\_\_\_\_

Date

JAN 5 - 1938 19

H. D. Hatfield Scout

Rice **KANSAS**

Map No. 49 Sec. 7 Twp. 20 R. 9W

Well No. 4 Foote

Saco Company

Contractor

**COMPLETED**

**SE NE**

\_\_\_\_\_ Ft. from N. Line

330 Ft. from S. Line

330 Ft. from E. Line

\_\_\_\_\_ Ft. from W. Line

**SECTION PLAT**

			0

Location \_\_\_\_\_

Rig up \_\_\_\_\_

Drilling and Remarks:

*3000 acid*

*POT 677*

**RECORD**

Cased 5 in., 3276 ft.

Sand Arb 3276

Gas \_\_\_\_\_

Oil \_\_\_\_\_

Total Depth 3281

**PRODUCTION**

1st 24 hrs. Nat. \_\_\_\_\_

1st 24 hrs. after shot \_\_\_\_\_

Gas \_\_\_\_\_ Cu. Ft.

Dry Hole \_\_\_\_\_

Abandoned \_\_\_\_\_

Date

**MAR 16 1938**

19

**H. D. Hatfield** Scout