

KANSAS


FORM 51 5M 6-46 PETROL

Rice

Section 7 Township 20 Range 9W

Well No. 5 McFarland

Company Lario Oil & Gas.

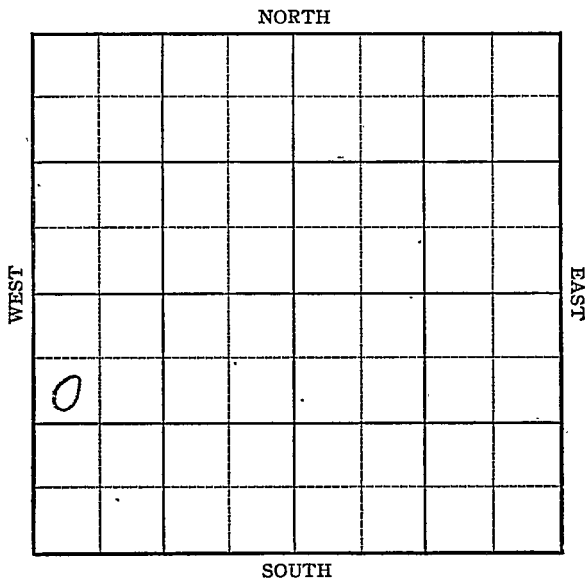

KANSAS

Rice County



Sec. 7 Twp. 20 R. 9W

Well No. #5 McFarland Farm

Lario Oil & Gas Company

Chase


990 Ft. from N. Line

 Ft. from S. Line

 Ft. from E. Line

330 Ft. from W. Line

SW NW SW

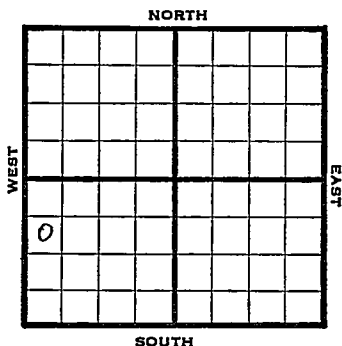

1946

1757

REPORT

7/3

RUR

7/9

"

7/16

8" @ 140

Dr1g 2747'

7/23

Lans 2958

Arb 3269'

5" @ 3272

TD 3275 RUST

7/30

"

"

8/20

Pump 12½ oil PH 14 hrs

8/28

Arb 3269'

5" @ 3272'

TD 3280

3000 Acid

Pump 100 Pot

42 GRAV

COMPLETED

KANSAS Kansas Pool Name Chase
 Map No. 49 Sec. 7 Twp. 20 R. 9W
 Well No. 5 McFarland

Lario Dil & Gas Company

FIRST REPORT

Contractor

SW NW SW

SECTION PLAT

o			
—			

990 Ft. from N. Line

_____ Ft. from S. Line

_____ Ft. from E. Line

330 Ft. from W. Line

Rice County

Location _____

Rig up _____

Drilling and Remarks:

RHR

RECORD

Cased _____ in., _____ ft.

Sand _____

Gas _____

Oil _____

Total Depth _____

PRODUCTION

1st 24 hrs. Nat. _____

1st 24 hrs. after shot _____

Gas _____ Cu. Ft.

Dry Hole _____

Abandoned _____

Date

JUL 3 1946 19 S. J. LEWIS Scout


Pool Name Chase Pool

Kansas

Map No. KANSAS 27 Sec. 7 Twp. 20 R. 9WWell No. 5 McFarlandLario Oil & Gas Company**COMPLETED**

Contractor

SW NW SW

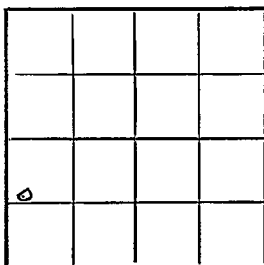E11757
SECTION PLAT990 Ft. from N. Line Ft. from S. Line Ft. from E. Line330 Ft. from W. LineRice County**RECORD**Location Rig up

Drilling and Remarks:

Art 32675" 3272..3000 acidPump 100 BD42 2/3Cased in., ft.Sand Gas Oil Total Depth 3280**PRODUCTION**1st 24 hrs. Nat. 1st 24 hrs. after shot Gas Cu. Ft.Dry Hole Abandoned

Date

AUG. 28 1946 19S. J. LEWIS

Scout