


Rice
9w

Map No. **KANSAS** Sec. 7 Twp. 20 R. 9w

Well No. 4-1 Mc Farland Farm
Shell Pet Company

NORTH

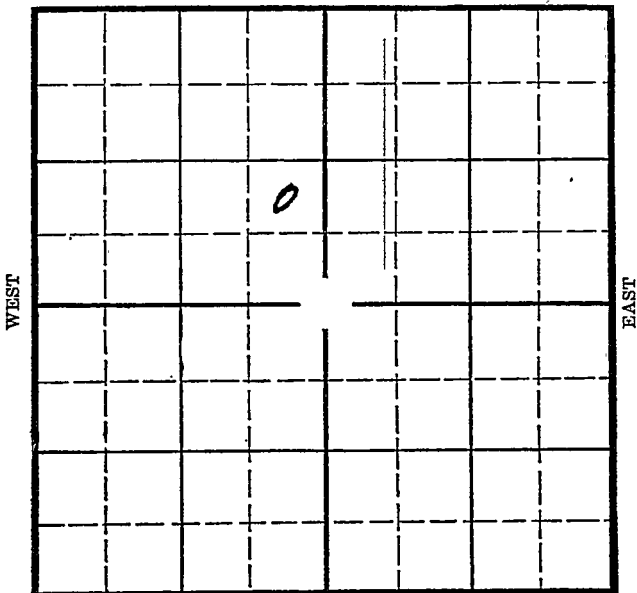

SOUTH

Location _____
Drilling Remarks _____

Rig Up _____
Drilling Remarks _____

RECORD

PRODUCTION

Cased _____ in. _____ ft.
Sand _____
Gas _____
Oil _____
Total Depth _____

1st 24 hrs. Nat. _____
1st 24 hrs. after shot _____
Gas _____ cu. ft. _____
Dry Hole _____
Abandoned _____

Rice

Map No. KANSAS Sec. 7 Twp. 20 R. 9W

Well No. 4-McFarland Farm
Shell Pit Company


_____ Ft. from N. Line

990 Ft. from S. Line

990 Ft. from E. Line

_____ Ft. from W. Line

Elev. 1747

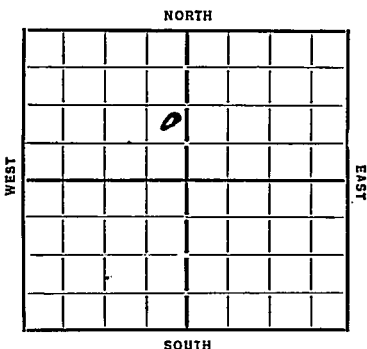

Date

REPORT

1935
6/12 Bldg Rig
6/20 Bldg
6/28 Bldg 1690
7/3 " 2650
7/11 " 3224 Cong 3215
7/18 —
7/31 Top Siliceous 3274
T.D. 3287
1142 oil
285 water

COMPLETED

Map No. 49 Sec. 7 Twp. 20 R. 9W

Well No. H-McFarland

Shell pet. Company

Contractor

FIRST REPORTS

SECTION PLAT

.....Ft. from N. Line

990 Ft. from S. Line

330 Ft. from E. Line

.....Ft. from W. Line

| | | | |
|--|---|--|--|
| | | | |
| | 0 | | |
| | | | |
| | | | |
| | | | |

Location.....

Rig up.....

Drilling and Remarks:

Bed Rig

RECORD

Cased.....in.,ft.

Sand.....

Gas.....

Oil.....

Total Depth.....

PRODUCTION

1st 24 hrs. Nat.....

1st 24 hrs. after shot.....

Gas.....Cu. Ft.

Dry Hole.....

Abandoned.....

Date

6-12-35

192

ORVAL MANNSCHECK

Scout

Map No. 49 Sec. 7 Twp. 20 R. 9W

Well No. 4-McFarland

Shell pet. Company

Contractor

~~CONFIDENTIAL~~

SECTION PLAT

..... Ft. from N. Line

990 Ft. from S. Line

330 Ft. from E. Line

..... Ft. from W. Line

| | | | |
|--|---|--|--|
| | | | |
| | 0 | | |
| | | | |
| | | | |

Location.....

Rig up.....

Drilling and Remarks:

1142 oil
285 water

~~RECORD~~

Cased..... ft.

Sand 3274

Gas.....

Oil.....

Total Depth 3287

PRODUCTION

1st 24 hrs. Nat.....

1st 24 hrs. after shot.....

Gas..... Cu. Ft.

Dry Hole.....

Abandoned.....

Date

~~FRANK MANNSCHECK~~

7-31-35 192.....

Scout