


Map No. **KANSAS** Sec. **7** Twp. **20** R. **9^W** *Rice*
 Well No. **H-Sharp** Farm
Sinclair & Prairie Company

NORTH

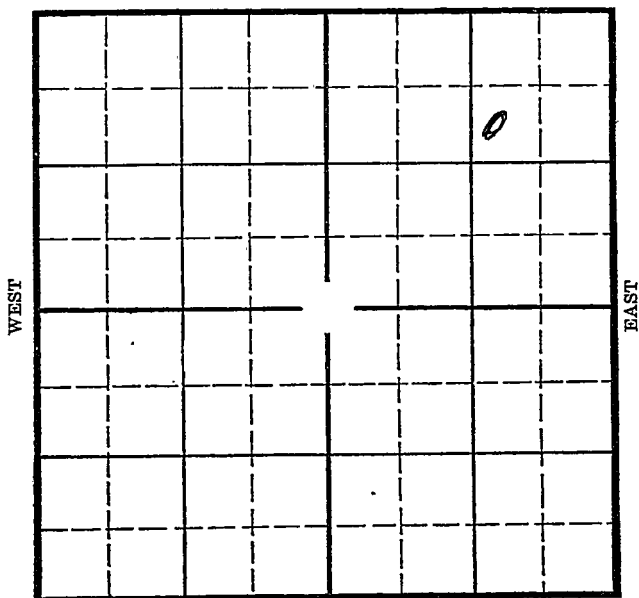

SOUTH

Location_____

Drilling Remarks_____

Rig Up_____

Drilling Remarks_____

RECORD

Cased_____in._____ft.

Sand_____

Gas_____

Oil_____

Total Depth_____

PRODUCTION

1st 24 hrs. Nat._____

1st 24 hrs. after shot_____

Gas_____cu. ft._____

Dry Hole_____

Abandoned_____

Rice
900

Map No. **KANSAS** Sec. **7** Twp. **20** R. **900**

Well No. **4-Sharp** Farm
Sinclair-Prairie Company


990 Ft. from N. Line

_____ Ft. from S. Line

1047 Ft. from E. Line

_____ Ft. from W. Line

Elev. 1736

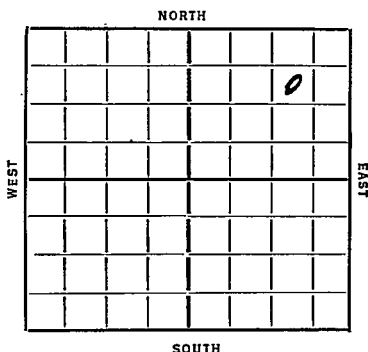

Date	REPORT
12/23	Spib Ring
12/26	Rgn
1/10	16" 168 Topok 2400
	Blg 2450
1/17	Top Sil 3248
	TD 3250
	Saturated core
1/24	7" 3244 Blg plug
1/31	TD 3265
	Set Core 3254-57
	800' Oil 36 hrs 2000 acid
2/7	Swabbed 14" Oil 8 hrs.
	TD 3272 1/2 3000' Oil
	Swabbed 35' Oil 1 hr.
2/14	1000 acid
	Swabbed 429 Oil 10 hrs
	172 Bbls next 4 hrs.
2/24	Setting pumping unit
2/28	Dry pot
3/4	Sil 3248 TD 3272 1/2
	1000 acid
	996 Bbls.

COMPLETED

Map No. 49 Sec. 7 Twp. 20 R. 9WWell No. 4-SharpSinclair Prairie Company

Contractor

FIRST REPORT

SECTION PLAT

			0

990 Ft. from N. Line

Ft. from S. Line

1047 Ft. from E. Line

Ft. from W. Line

Location

Rig up

Drilling and Remarks:

Spid Rig

RECORD

Cased in., ft.

Sand

Gas

Oil

Total Depth

PRODUCTION

1st 24 hrs. Nat.

1st 24 hrs. after shot

Gas Cu. Ft.

Dry Hole

Abandoned

Date

ORVAL MANNSCHRECK

12-23-35 192

Scout

KANSAS

Map No. 40 Sec. 7 Twp. 20 R. 9WWell No. 4-SharpSinclair-Prairie Company

Contractor

COMPLETE

990 Ft. from N. Line

Ft. from S. Line

1047 Ft. from E. Line

Ft. from W. Line

SECTION PLAT

			0

Location

Rig up

Drilling and Remarks:

1000 acid996 bbls

RECORD

Cased in. 3248 ft.Sand oil

Gas

Oil

Total Depth 3272 1/2

PRODUCTION

1st 24 hrs. Nat.

1st 24 hrs. after shot

Gas Cu. Ft.

Dry Hole

Abandoned

Date

3-4-36 192 ORVAL MANNSCHRECK Scout