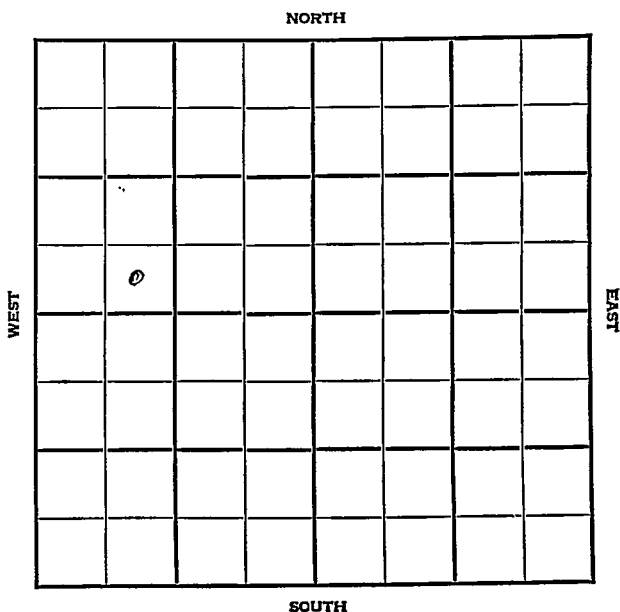


KANSAS

Section 7 Township 20 Range 9THWell No. #5 McFarlandCompany Producers Pipe & Supply

KANSAS Rice

Sec. 7 Twp. 20 R. 9W

Well No. #5 McFarland Farm

Producers Pipe & Supply Company
Chase


 Ft. from N. Line

330 Ft. from S. Line

 Ft. from E. Line

990 Ft. from W. Line

SE SW NW

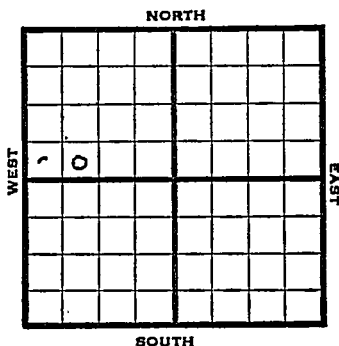

1947 Elev. 1743' REPORT

11/19 13" @ 163'
Drlg. 1370'

11/25 Drlg. 2862'

12/3 Lansing 2940'
Arbuckle 3292'
TD 3294'
7" @ 3293'
RUST

12/10 "

12/17 12 shots 3038-41 CO

1948

1/7 Lans. 2940'
Arb. 3292'
7" @ 3293'
Perf. Lans.
1500 Acid
Pump 300 Pot.
Gr. 42°
Total Depth 3294'
COMPLETED

Map No. _____ Sec. 7 Twp. 20 R. 9WWell No. 5 McFarland

Producers Pipe & Supply Company

FIRST REPORT Contractor


SE SW NW

SECTION PLAT

_____ Ft. from N. Line

330 Ft. from S. Line

_____ Ft. from E. Line

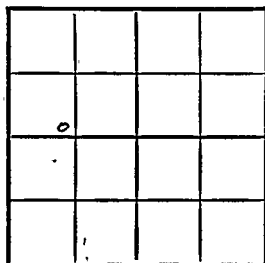990 Ft. from W. Line

Rice County

Location _____

Rig up _____

Drilling and Remarks:

13" @ 163drlg. 1370

RECORD

Cased _____ in., _____ ft.

Sand _____

Gas _____

Oil _____

Total Depth _____

PRODUCTION

1st 24 hrs. Nat. _____

1st 24 hrs. after shot _____

Gas _____ Cu. Ft.

Dry Hole _____

Abandoned _____

Date

NOV 19 1947 19 S. J. LEWIS Scout

Map No. 49 Sec. 7 Twp. 20 R. 9W

Well No. 5 McFarland

Producers Pipe & Supply Company

COMPLETE

Contractor

SE SW NW


E 11748
SECTION PLAT

 Ft. from N. Line

330 Ft. from S. Line

 Ft. from E. Line

990 Ft. from W. Line

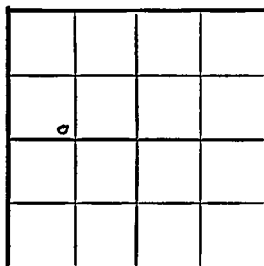

Rice County

Location

Rig up

Drilling and Remarks:

Lane 2940

Cr Y 3292

7" @ 3293

Perf done.

1500 acid

Pump 300 PSI

42 2/3

RECORD

Cased in., ft.

Sand

Gas

Oil

Total Depth 8294

PRODUCTION

1st 24 hrs. Nat.

1st 24 hrs. after shot

Gas Cu. Ft.

Dry Hole

Abandoned

Date

JAN 7 1948 19

S. J. LEWIS

Scout