

KANSAS


Rice

Form 51-5M-4-36-Palace

Section 7 Township 20 Range 9W


Well Number #6 Sharpe

Company Sinclair-Prairie

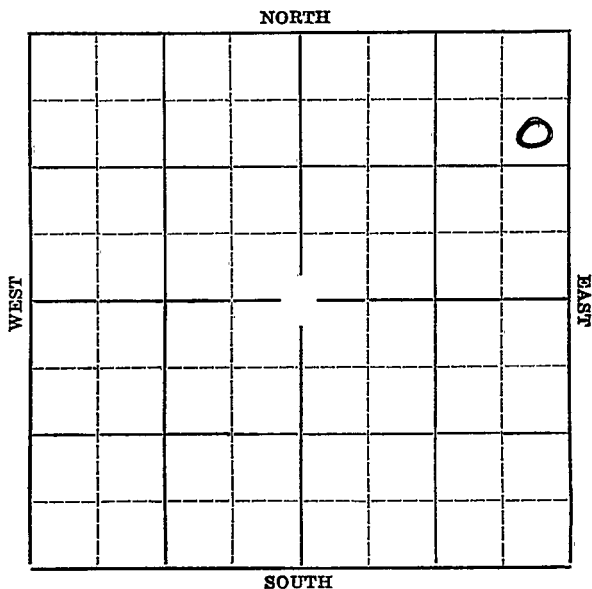

Map No. KANSAS Sec. 7 Twp. 20 R. 9WWell No. #6 Sharpe FarmSinclair-Prairie Company990' Ft. from N. Line Ft. from S. Line330' Ft. from E. Line Ft. from W. Line

Elev. 1733

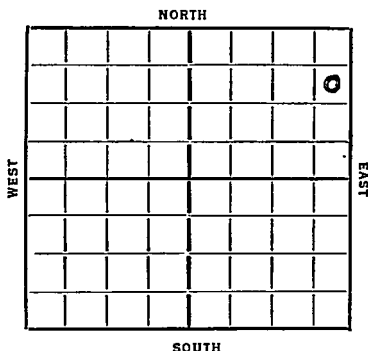Date
1936

REPORT

5/20 13" @ 166' WOC.

5/28 Drlg. 2540'.

6/4 Sil. 3151'. T.D. 3152' set 7".

6/11 3268½'. T.D. 1000' oil.

7/1/36 Sil. 3251'.

3277'. LB.W.

T.D. 3277'.

P.B. 3275'.

1,000 gallons of acid.

412 bbls of oil and 60 bbls of water.

COMPLETED

KANSAS

Map No. 49 Sec. 7 Twp. 20 R. 9 WWell No. 6 SharpeSinclair-Prairie Company

Contractor

SECTION PLAT

			o
///			

990 Ft. from N. Line

_____ Ft. from S. Line

330 Ft. from E. Line

_____ Ft. from W. Line

FIRST REPORT

Location _____

Rig up _____

Drilling and Remarks:

13" C 166 WOC

RECORD

Cased _____ in., _____ ft.

Sand _____

Gas _____

Oil _____

Total Depth _____

PRODUCTION

1st 24 hrs. Nat. _____

1st 24 hrs. after shot _____

Gas _____ Cu. Ft.

Dry Hole _____

Abandoned _____

Date

MAY 10 1936 19

S. J. LEWIS

Scout

Map No. 49 Sec. 7 Twp. 20 R. 9WWell No. 6 SharpeSinclair-Prairie Company

Contractor

SECTION PLAT

			0

990 Ft. from N. Line

_____ Ft. from S. Line

330 Ft. from E. Line

_____ Ft. from W. Line

COMPLETED

Location _____

Rig up _____

Drilling and Remarks:

SL 3251
3277/BW.
PK 3275
1000 acid
412 oil
60 water

RECORD

Cased _____ in., _____ ft.

Sand _____

Gas _____

Oil _____

Total Depth 3277

PRODUCTION

1st 24 hrs. Nat. _____

1st 24 hrs. after shot _____

Gas _____ Cu. Ft.

Dry Hole _____

Abandoned _____

Date

JUL 1 1936₁₉

S. J. LEWIS Scout