


Section 7 Township 20 Range 9-W

Well No. #9 McFarland

Company Producers Pipe & Supply
Chase Pool

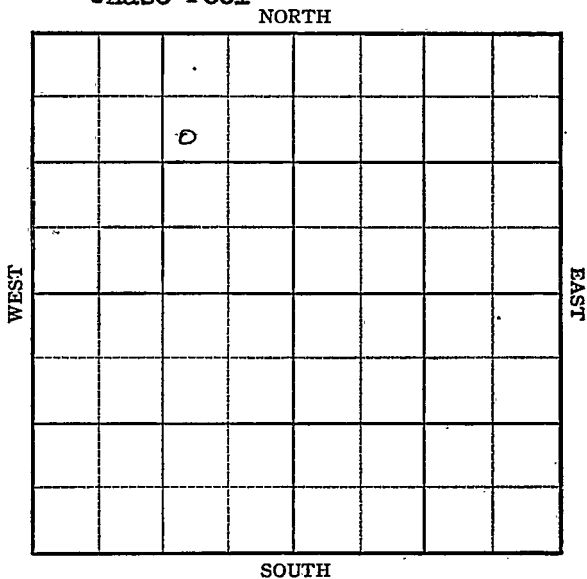

Rice

Sec. 7 Twp. 20 R. 9W

Well No. #9 McFarland Farm

Producers Pipe & Supply Company

Chase Pool


990' Ft. from N. Line

_____ Ft. from S. Line

_____ Ft. from E. Line

1450' Ft. from W. Line

SW NE NW

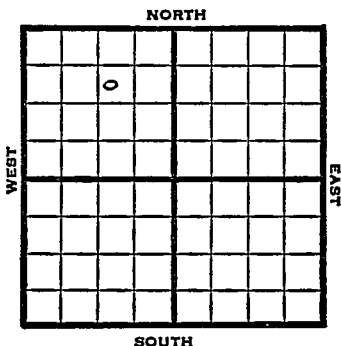

1949

REPORT

11/16 Surface Hole

11/23 8" @ 205'

Lansing 2940'

Arb. 3239-42'

TD 3242'

7" @ 3241'

11/29 " "

12/7 " "

12/14 Arb 3239'

7" @ 3241'

Pump 50 oil Pot.

TD 3249'

Gr. 42°

Comp

Est. 50 Blt. net

Harry Davis

COMPLETED

Map No. _____ Sec. 7 Twp. 20 R. 9W

Well No. 9 McFarland

Producers Pipe & Supply Company

Contractor

SW-NE NW

**FIRST REPORT
SECTION PLAT**

990 Ft. from N. Line

_____ Ft. from S. Line

_____ Ft. from E. Line

1450 Ft. from W. Line

	o		
.			

Rice County

Location _____

Rig up _____

Drilling and Remarks:

surface hole

RECORD

Cased _____ in., _____ ft.

Sand _____

Gas _____

Oil _____

Total Depth _____

PRODUCTION

1st 24 hrs. Nat. _____

1st 24 hrs. after shot _____

Gas _____ Cu. Ft.

Dry Hole _____

Abandoned _____

Date

NOV 16 1949

19

S. J. LEWIS

Scout

Map No. _____ Sec. 7 Twp. 20 R. 9W

Well No. 9 McFarland

Producers Pipe & Supply Company

COMPLETE

Contractor

SW NE NW

E11742
SECTION PLAT

990 Ft. from N. Line

_____ Ft. from S. Line

_____ Ft. from E. Line

1450 Ft. from W. Line

	o		

Rice County

Location _____

Rig up _____

Drilling and Remarks:

Curr 3239
7" @ 3241

Pump 5000 lb

420 lb

RECORD

Cased _____ in., _____ ft.

Sand _____

Gas _____

Oil _____

Total Depth 19249

PRODUCTION

1st 24 hrs. Nat. _____

1st 24 hrs. after shot _____

Gas _____ Cu. Ft.

Dry Hole _____

Abandoned _____

Date

DEC 14 1949 19

S. J. LEWIS

Scout