


Section 7 Township 20 Range 9 W

Well No. # 12 McFarland

Company Producers Pipe & Supply

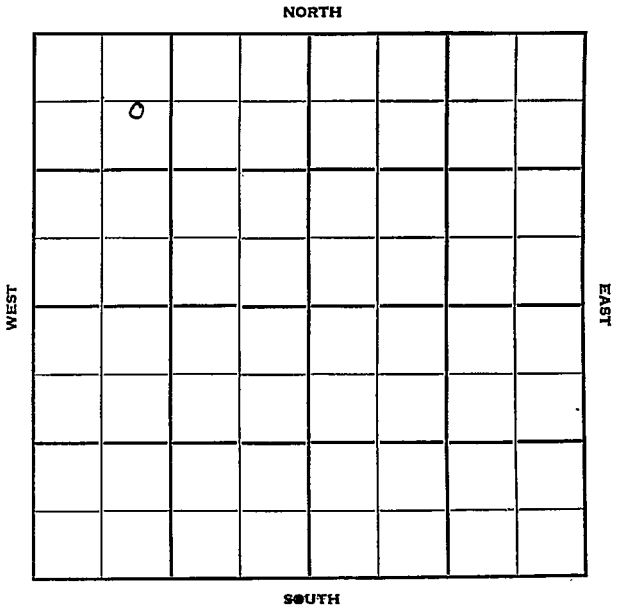

Rice

KANSAS

Sec. 7 Twp. 20 R. 9 W ✓

Well No. # 12 McFarland Farm

Producers Pipe & Supply Company

Contractor

Chase Pool


730 Ft. from N. Line

Ft. from S. Line

Ft. from E. Line

909 Ft. from W. Line

SE NW NW

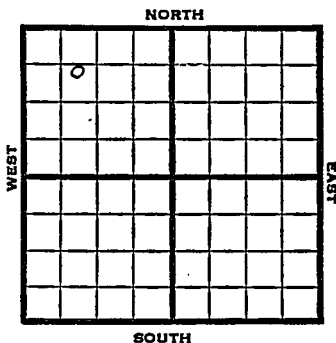

1951

Elev. 1740' REPORT

7/3

Spud 6-28-51  
Drlg. 1805'

8/15

Spud 6-28-51  
SWD Well TD. 3827  
Br Line 2919 Lans. 2947  
Simp. 3243 Arb. 3275  
DST 3281-86 opn 1 hr  
Rec. 90' oil 450' wtr  
7" @ 3358 TD 3827  
2000 A Comp. for SWD well  
Input 150 bswph

**ABANDONED**



