

KANSAS


RICE

Form 51-5M-4-36-Palace

Section 7 Township 20 Range 9-W

Well Number #5-Sharpe


Company Sinclair-Prairie

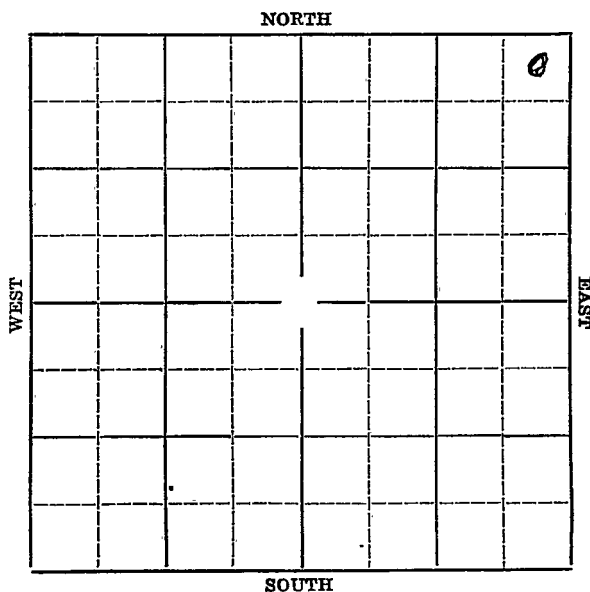

O. W. P. B.

Map No. **KANSAS** Sec. 7 Twp. 20 R. 9-WWell No. 5-Sharpe FarmSinclair-Prairie Company330 Ft. from N. Line Ft. from S. Line330 Ft. from E. Line Ft. from W. Line

Elev. 1731

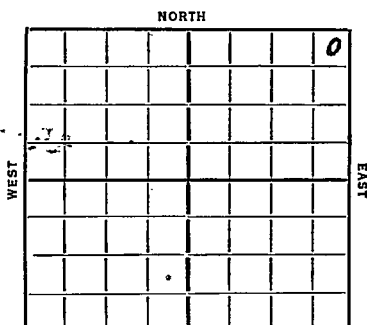Date
1936REPORT **O. W. P. B.**

4/15 Location

4/23 Drlg. 1380'

4/30 Drlg. 2988'. K.C.L. 2950'

5/7 Sil. 3242' T.D. 3248'. 7" @ 3240'.

5/14 326½' 1000 acid. Swab 415 bbls in
15 hours.

5/21 458 bbls.

5/28 --

6/4 Testing.

6/10/36-Sil. 3242'.

Total depth 3262½'.

1000 gallons acid.

406 bbls oil and 200 bbls water

COMPLETED**OVER**

1938

O. W. P. B.

7/27

K. C. 2950'.

Old T. D. 3262' in Arb.

P. B. 3100' in K. C.

Perf. 100 shots. 2942-54'.

2000 acid.

Pump 74 oil in 24 hrs.

No water.

FIRST REPORT



COMPLETED

KANSAS

Map No. 49 Sec. 7 Twp. 20 R. 24Well No. 5 SharpeSinclair & Prairie Company

Contractor

SECTION PLAT

330 Ft. from N. Line

Ft. from S. Line

330 Ft. from E. Line

Ft. from W. Line

			0

FIRST REPORT

Location ✓

Rig up

Drilling and Remarks:

RECORD

Cased _____ in., _____ ft.

Sand _____

Gas _____

Oil _____

Total Depth _____

PRODUCTION

1st 24 hrs. Nat. _____

1st 24 hrs. after shot _____

Gas _____ Cu. Ft.

Dry Hole _____

Abandoned _____

Date

APR 15 1936

S. J. LEWIS

192

Scout

Map No. 49 **KANSAS** Sec. 7 Twp. 20 R. 9 W

Well No. 5 Sharp

Sinclair Prairie Company

Contractor

SECTION PLAT

			o

320 Ft. from N. Line

_____ Ft. from S. Line

330 Ft. from E. Line

_____ Ft. from W. Line

COMPLETED

Location _____

Rig up _____

Drilling and Remarks:

Sil 3242

1000 acid

406 oil

200 water

RECORD

Cased _____ in., _____ ft.

Sand _____

Gas _____

Oil _____

Total Depth 3262 1/2

PRODUCTION

1st 24 hrs. Nat. _____

1st 24 hrs. after shot _____

Gas _____ Cu Ft.

Dry Hole _____

Abandoned _____

Date

JUN 10 1936 19

Scout

KANSAS

Rice

Map No. 49 Sec. 7 Twp. 20 R. 9WWell No. 5 SharpSinclair Prairie

Company

FIRST REPORT

Contractor

COMPLETED

NE/C

330 Ft. from N. Line Ft. from S. Line330 Ft. from E. Line Ft. from W. Line

SECTION PLAT

			0

Location Rig up

Drilling and Remarks:

KC 2950

OTD-3262 in Arb.

PB 3100 in KC

Perf 100 Shots

2942-54

2000 acid

Pump 74 oil in 24 Hrs.

No Water

RECORD

Cased in., ft.Sand Gas Oil Total Depth

PRODUCTION

1st 24 hrs. Nat. 1st 24 hrs. after shot Gas Cu. Ft.Dry Hole Abandoned

Date

JUL 27 1938

19

H. D. Hatfield

Scout