


Rice

Map No. **KANSAS** Sec. 7 Twp. 20 R. 9^W
 Well No. 2 Mc Garland Farm
Guyas Co. Company

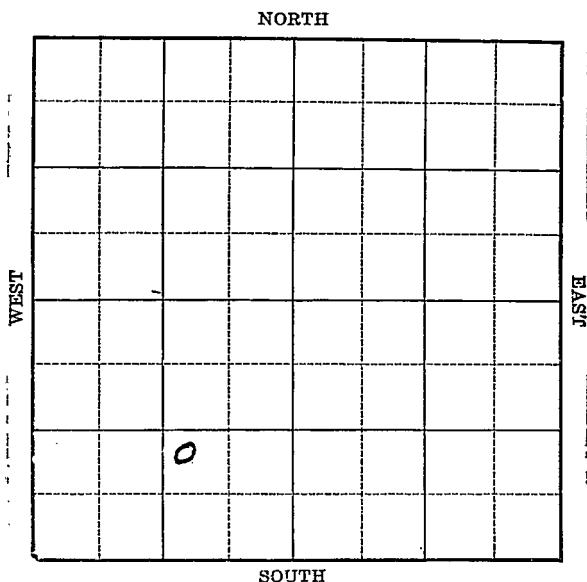

Location _____

Drilling Remarks _____

Rig Up _____

Drilling Remarks _____

RECORD

Cased _____ in. _____ ft.

Sand _____

Gas _____

Oil _____

Total Depth _____

PRODUCTION

1st 24 hrs. Nat. _____

1st 24 hrs. after shot _____

Gas _____ cu. ft.

Dry Hole _____

Abandoned _____

Rice


Map No. KANSAS Sec. 7 Twp 20 R. 9W
Well No. 2 Mc Garland Farm
Gyasi Co. Company

 Ft. from N. Line

990 Ft. from S. Line

1129 Ft. from E. Line

 Ft. from W. Line

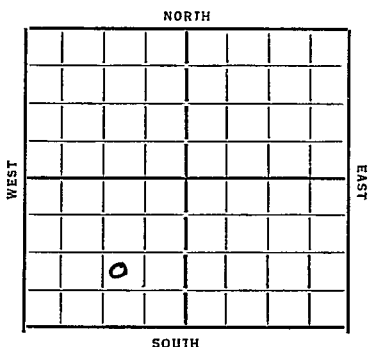

Date 1934

REPORT

4/25 Cellar
5/3 Spud
5/10 Dlg 1855 12 1/2 153
5/18 " 2790 3297
5/25 T Siliceous 3296 Coring
5/31 T Siliceous 3297 8" 3300
TD 3318 SD
6/7 1000 acid Bailing
6/14 TD 3344 PB 3297 Bailing
6/21 Acidizing
6/28
7/5 100 qt shot
7/12
7/18 Siliceous 3297 TD 3344
PB 3297 1000 acid 100 qts shot
D & A

ABANDONED

KANSAS

Map No. 49 Sec. 7 Twp. 20 R. 9WWell No. 2. McFarlandTexas Co Company

Contractor

FIRST REPORTS

SECTION PLAT

	0		

Ft. from N. Line

990 Ft. from S. Line1129 Ft. from E. Line

Ft. from W. Line

Location

Rig up

Drilling and Remarks:

cellar

RECORD

Cased _____ in., _____ ft.

Sand _____

Gas _____

Oil _____

Total Depth _____

PRODUCTION

1st 24 hrs. Nat. _____

1st 24 hrs. after shot _____

Gas _____ Cu. Ft.

Dry Hole _____

Abandoned _____

Date

4-25-34 19ORVAL MANNSCHRECK
Scout

WSAS

Map No. 49 Sec. 7 Twp. 20 R. 9WWell No. 2-McFarlandTefaco Co Company

Contractor

ABANDONED

SECTION PLAT

	0		

Ft. from N. Line

990 Ft. from S. Line1129 Ft. from E. Line

Ft. from W. Line

Location

Rig up

Drilling and Remarks:

P.B. 3297.
1000 and
100 qts. shot
10 + ft

RECORD

Cased _____ in., _____ ft.

Sand Shuono 3297

Gas _____

Oil _____

Total Depth 3344

PRODUCTION

1st 24 hrs. Nat. _____

1st 24 hrs. after shot _____

Gas _____ Cu. Ft.

Dry Hole _____

Abandoned _____

Date

7-18-37 19

ORVAL MANNSCHRECK

Scout