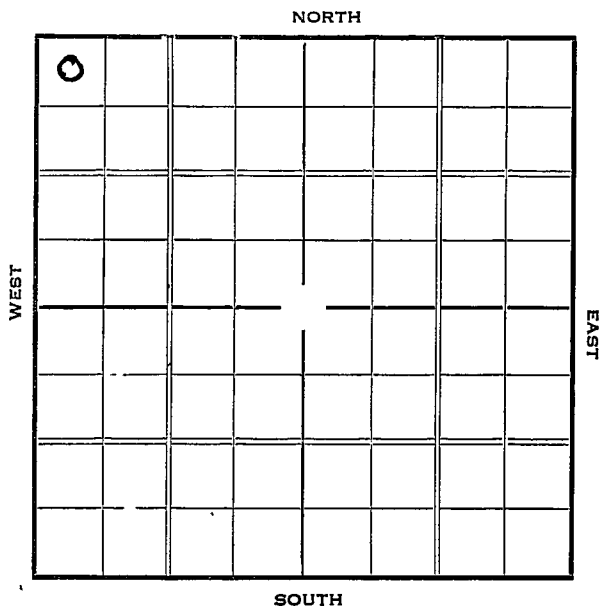


Rice

KANSAS

Section 7 Township 20 Range 9-WWell Number 2 - McFarlandCompany Davis et al

1937

8/11

5^{III}/₇ @ 3288'.

Sil. 3288'.

T.D. 3300'.

Pot. 190 bbls. Nat.

COMPLETED

KANSAS

Map No. 49 Sec. 7 Twp. 20 R. 9 ^WWell No. 2 - McFarlandDavis et al Company

Contractor

FIRST REPORT

330 Ft. from N. Line

_____ Ft. from S. Line

_____ Ft. from E. Line

330 Ft. from W. Line

SECTION PLAT

0			

Location _____

Rig up _____

Drilling and Remarks:

cellar

RECORD

Cased _____ in., _____ ft.

Sand _____

Gas _____

Oil _____

Total Depth _____

PRODUCTION

1st 24 hrs. Nat. _____

1st 24 hrs. after shot _____

Gas _____ Cu. Ft.

Dry Hole _____

Abandoned _____

Date

APR 28 1937 19

H. D. Hatfield Scout

Rice KANSAS

Map No. 49 Sec. 7 Twp. 20 R. 9WWell No. 2 - McFarlandDavis et al Company

Contractor

CORRECTION

SECTION PLAT


330 Ft. from N. Line

_____ Ft. from S. Line

_____ Ft. from E. Line

909 Ft. from W. Line

CORRECTION

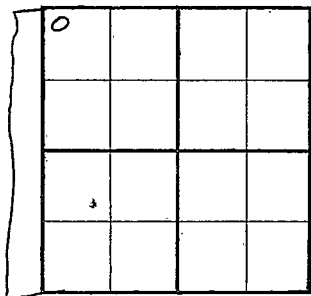

Location _____

Rig up _____

Drilling and Remarks:

Note:

This is a long
section

RECORD

Cased _____ in., _____ ft.

Sand _____

Gas _____

Oil _____

Total Depth _____

PRODUCTION

1st 24 hrs. Nat. _____

1st 24 hrs. after shot _____

Gas _____ Cu. Ft.

Dry Hole _____

Abandoned _____

Date

MAY 5 - 1937 19

H. D. Hatfield Scout

Rice KANSAS

Map No. _____ Sec. 7 Twp. 20 R. 9^WWell No. 2 - McFarlandDavis et al Company

Contractor

COMPLETED

Long Section
SECTION PLAT330 Ft. from N. Line100 Ft. from S. Line

_____ Ft. from E. Line

909 Ft. from W. Line

0			

Location: _____

Rig up _____

Drilling and Remarks:

Pot - 190

nat

RECORD

Cased 5 in. 3288 ft.Sand 511 3288

Gas _____

Oil _____

Total Depth 3300

PRODUCTION

1st 24 hrs. Nat. _____

1st 24 hrs. after shot _____

Gas _____ Cu. Ft.

Dry Hole _____

Abandoned _____

Date

AUG 11 1937 19 H. D. Hatfield Scout