

McPherson

Form 51-5M-2-29-34703

Map No. KANSAS Sec.

Twp.

R.

Well No.

Farm

Company

NORTH

WEST

EAST

SOUTH

Location
Drilling Remarks

Rig Up
Drilling Remarks

RECORD

Cased _____ in. _____ ft.
Sand _____
Gas _____
Oil _____
Total Depth _____


PRODUCTION

1st 24 hrs. Nat. _____
1st 24 hrs. after shot _____
Gas _____ cu. ft.
Dry Hole _____
Abandoned _____

Map No. KANSAS Sec. 7 Twp. 20 R. 12W

Well No. 3- Anna Klein Farm
Palmer-Phillips & Shell Company

NORTH

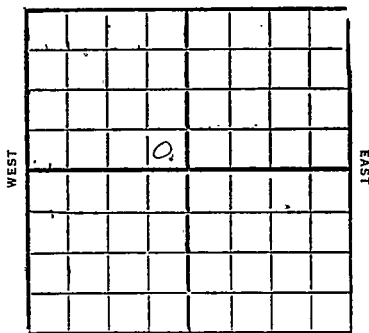

 Ft. from N. Line

330 Ft. from S. Line

330 Ft. from E. Line

 Ft. from W. Line

1931

Date

REPORT

11/5	Drill rig
11/10	Rig up
11/18	15"-549
11/24	Drill 575'
12/2	" 1260'
12/9	" 1845'
12/16	HFV 2121
12/23	U/R 10"-2235'
12/30	10"-2295'
1/6	Drill 2305'
1/13	4 barrels water
1/20	from 2440-55
1/27	Drill 2730'
2/3	Chut 2930
2/10	show gas 2933
2/17	Drill up U/R logs
2/24	Increase gas 2944-46
2/28	show oil 3008
3/6	Drill 3070'
3/13	U/R 8"-3070'
	(over)

1/20- Top Viola 3397
First oil 3399
T.D. 3405

1000 ft oil in 4 hrs
1/27- TD 3405'
shot 15 qt 3399-3405
2800' oil in hole
Rng 3" tubing

2/3- Viola 3397-3405
T.D. 3405
shot 15 qt 3399-3405
Pump 1278 bbl
Potential
Comp.

1932

OWDD

11/2- Old TD 3405'
Top Viola 3397
6"-3423
dreg 3434
Increase water

11/9- Base Viola 3438
6"-3437

Welcox 3440-43

2000 ft oil 1 hr

2700 ft. oil 12 hr

11/16- Cased 6"-3437
Welcox 3440-43
TD 3443

Pump 996 bbl 24 hr
Comp.

Ms Pherson
 43 KANSAS Sec. 7 Twp. 20 R. 1 W
 Well No. 3 Anna Wein
Palmer-Phillips & Steel Company
 Contractor

FIRST REPORTS


.....Ft. from N. Line

330 Ft. from S. Line

330 Ft. from E. Line

.....Ft. from W. Line

SECTION PLAT

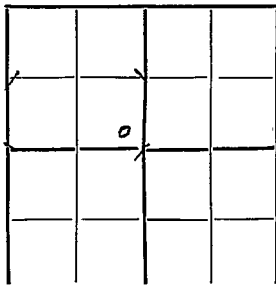

Location.....

Rig up.....

Drilling and Remarks:

RECORD

Cased.....in.,ft.

Sand.....

Gas.....

Oil.....

Total Depth.....

PRODUCTION

1st 24 hrs. Nat.....

1st 24 hrs. after shot.....

Gas.....Cu. Ft.

Dry Hole.....

Abandoned.....

Date

NOV 4 1931 CHAS. L. SHERWOOD
 192 Scout

43 KANSAS

Map No. _____ Sec. 7 Twp. 20 R. 1

Well No. 3 Anna Mein

Palmer-Phillips & Shelt Company
Contractor

COMPLETED

SECTION PLAT

_____ Ft. from N. Line

330 Ft. from S. Line

330 Ft. from E. Line

_____ Ft. from W. Line

Location _____

Rig up _____

Drilling and Remarks:

Shot 15/3399-3405

Potential Pump
1278 Bls.

RECORD

Cased _____ in. _____ 2 ft.

Sand _____ 3397-3405

Gas _____

Oil _____

Total Depth 3405

PRODUCTION

1st 24 hrs. Nat. _____

1st 24 hrs. after shot _____

Gas _____ Cu. Ft.

Dry Hole _____

Abandoned _____

Date

FEB

3 1932

19 CHAS. L. CHERWOOD

Scout

McPherson

W

#3 KANSAS

Map No. Sec. 7 Twp. 20 R. 1

Well No. 3 Anna Wein

Palmer-Phillips & Shell Company

Contractor

FIRST REPORTS

Ft. from N. Line

330 Ft. from S. Line

330 Ft. from E. Line

Ft. from W. Line

SECTION PLAT

	110 W D		

Location

Rig up

Drilling and Remarks:

6" 3423

Og 3434
increase in water

RECORD

Cased in. ft.

Sand Top Viola 3397

Gas

Oil

Total Depth 3405

PRODUCTION

1st 24 hrs. Nat.

1st 24 hrs. after shot

Gas Cu. Ft.

Dry Hole

Abandoned

Date

NOV 2 1932 CHAS. L. SHERWOOD

192 Scout

McPherson

W

43 KANSAS

Map No. Sec. 7 Twp. 20 R. 1

Well No. 3 Anna Klein

Palmer-Phillips-Sheer Company

Contractor

COMPLETED

SECTION PLAT

Ft. from N. Line

330 Ft. from S. Line

330 Ft. from E. Line

Ft. from W. Line

Location

Rig up

Drilling and Remarks:

Pump 99% bbs
24 hours.

RECORD

Cased 6 in., 3437 ft.

Sand 3440 - 3443

Gas

Oil

Total Depth 3443

PRODUCTION

1st 24 hrs. Nat.

1st 24 hrs. after shot

Gas Cu. Ft.

Dry Hole

Abandoned

Date

NOV 1 6 1932 CHAS. L. SHERWOOD

192

Scout