


Section 7 Township 20 Range 1-WWell No. #1 PetersonCompany Roland Jones

KANSAS

McPherson

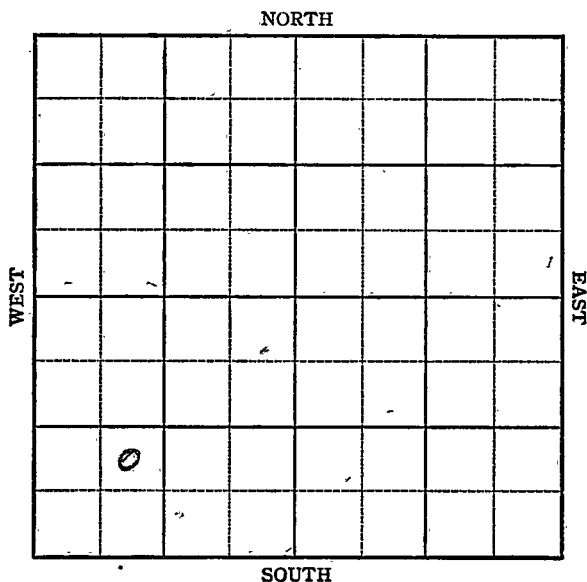

Sec. 7 Twp. 20 R. 1-W

Well No. # 1 Peterson Farm

Roland Jones Company

Ritz Canton


 Ft. from N. Line

990 Ft. from S. Line

 Ft. from E. Line

990 Ft. from W. Line

NE SW SW

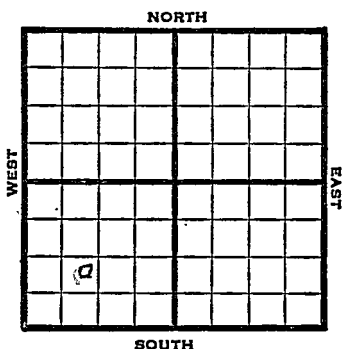

REPORT

1947 1555

2/5	Location
2/12	" "
2/19	8" @ 163' Drlg 1640'
2/26	Drlg 2926'
3/4	Viola 3403'-04 TD 3404' 5" @ 3403' RUST
3/11	TD 3404'
3/18	TD 3407' 100' oil & 700' water in 12 hrs
3/25	" "
4/2	Miss 2940' Viola 3403' TD 3407'.

ABANDONED

Map No. 43 Sec. 7 Twp. 20 R. 1W

Well No. 1 Peterson

Roland Jones Company

FIRST REPORT

Contractor

NE SW SW


SECTION PLAT

 Ft. from N. Line

990 Ft. from S. Line

 Ft. from E. Line

990 Ft. from W. Line

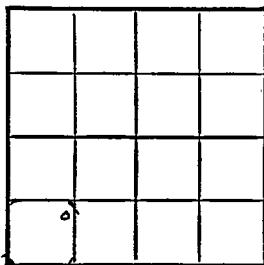

McPherson County

Location X

Rig up

Drilling and Remarks:

RECORD

Cased in, ft.

Sand

Gas

Oil

Total Depth

PRODUCTION

1st 24 hrs. Nat.

1st 24 hrs. after shot

Gas Cu. Ft.

Dry Hole

Abandoned

Date

FEB 5 1947 19

S. J. LEWIS Scout

Map No. K43 Sec. 7 Twp. 20 R. 1W

Well No. 1 Peterson

Roland Jones Company

ABANDONED

Contractor

NE SW SW

E. 1. 1555

SECTION PLAT

 Ft. from N. Line

990 Ft. from S. Line

 Ft. from E. Line

990 Ft. from W. Line

McPherson County

Location

Rig up

Drilling and Remarks:

Miss 2940
Vid 3408

RECORD

Cased in., ft.

Sand

Gas

Oil

Total Depth 3407

PRODUCTION

1st 24 hrs. Nat.

1st 24 hrs. after shot

Gas Cu. Ft.

Dry Hole

Abandoned

Date

APR 2 1947 19

S. J. LEWIS Scout