

McPherson


Form 51-5M-2-29-34703

Map No. **KANSAS** Sec. 7 Twp. 20 R. 12

Well No. 4 - Kenn Farm

Palmer Phillips & Steele Company

NORTH

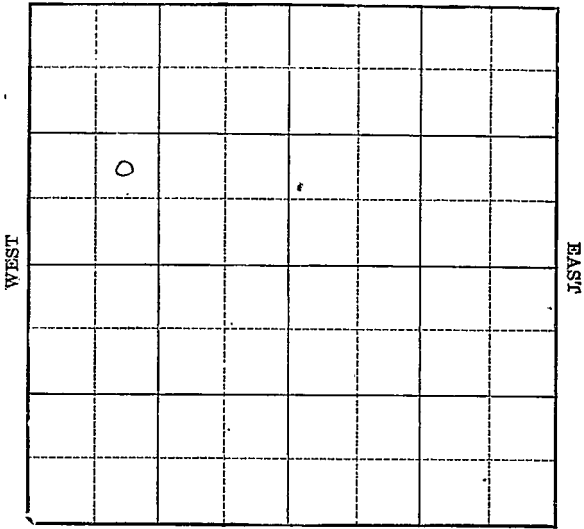

SOUTH

Location

Drilling Remarks

Rig Up

Drilling Remarks

RECORD

Cased in. ft.

Sand

Gas

Oil

Total Depth

PRODUCTION

1st 24 hrs. Nat.

1st 24 hrs. after shot

Gas cu. ft.

Dry Hole

Abandoned

Map No. KANSAS Sec. 7 Twp. 20 R. 12W
Well No. 4 - Kinn Farm
Calmur - Phillips & Shell Company


_____ Ft. from N. Line

990 Ft. from S. Line

_____ Ft. from E. Line

990 Ft. from W. Line

1932

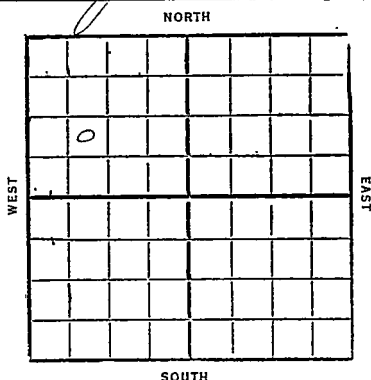

Date

REPORT

7/13	Bldg rig
7/20	20"-110'
7/27	—
8/3	15"-540
	12"-1407
	Drlg 1685
8/10	10"-2097
	HFV 2145-50
	drlg 2150'
8/17	" 2510'
8/24	No report
8/31	8"-2620
	Chat 2943-6"
	Gas 2943-48
	Inc gas 2953-59
	show oil & HFV 2977
	drlg 3050'
9/7	set 6"-3115'
	Clg out
	(over)

McPherson

W

43 KANSAS

Map No. _____ Sec. 7 Twp. 20 R. 1

Well No. 4 Minn

Palmer-Phillips & Shell Company

Contractor

FIRST REPORTS

SECTION PLAT

_____ Ft. from N. Line

990 Ft. from S. Line

_____ Ft. from E. Line

990 Ft. from W. Line

0			

Location _____

Rig up _____

Drilling and Remarks:

Bleg Rig

RECORD

Cased _____ in., _____ ft.

Sand _____

Gas _____

Oil _____

Total Depth _____

PRODUCTION

1st 24 hrs. Nat. _____

1st 24 hrs. after shot _____

Gas _____ Cu. Ft.

Dry Hole _____

Abandoned _____

Date

JUL 13 1932

CHAS. L. SHERWOOD

192

Scout

McPherson

43 KANSAS

Map No. _____ Sec. 7 Twp. 20 R. 1

Well No. 4 Winn

Palmer-Phillips & Shell Company

Contractor

COMPLETED

_____ Ft. from N. Line

990 Ft. from S. Line

_____ Ft. from E. Line

990 Ft. from W. Line

SECTION PLAT

0			

Location _____

Rig up _____

Drilling and Remarks:

Pump 280 Bl
20 Hrs.

RECORD

Cased 5 in., 3410 ft.

Sand Volar 3410-3415

Gas _____

Oil _____

Total Depth 3415

PRODUCTION

1st 24 hrs. Nat. _____

1st 24 hrs. after shot _____

Gas _____ Cu. Ft.

Dry Hole _____

Abandoned _____

Date

SEP 2 1 1932

192

CHAS. L. SHERWOOD

Scout

9/14- Base line 3190

6" 3115

Top Viola 3410

5" 3410

TD 3415

2000 ft. oil in hole

On pump

9/21-

Cased 5" 3410

Viola 3410-15

TD 3415

Pump 280 bbl 20 hr

Comp.