

Map No. 7 Sec. 7 Twp. 20 R. 6^W

Well No. 1-Bush Farm

Luna Oil Company

NORTH

WEST

EAST

SOUTH

Location _____

Drilling Remarks:

Rig Up _____

Drilling Remarks:

RECORD

Cased _____ in. _____ ft.

Sand _____

Gas _____

Oil_____

Total Depth _____

PRODUCTION

1st 24 hrs. Nat. _____

1st 24 hrs. after shot_____

Gas _____ cu. ft.

Dry Hole _____


Abandoned_____

Map No. K Sec. 7 Twp. 20 R. 6⁰⁰Well No. 6-Bush FarmGeno Oil Company200 Ft. from N. Line

_____ Ft. from S. Line

200 Ft. from E. Line

_____ Ft. from W. Line

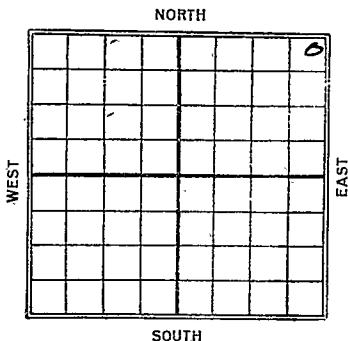

REPORT

19243/14Boys4/24D. & A. 310'11/22S.D. @ 3565' Tools moved out19251/21D. & A. 3565'

Map No. *Wm. H. HARRIS* Sec. *7* Twp. *20* R. *6W*

Well No. *#1 Bush*

Run oil Company

Contractor

FIRST REPORT

SECTION PLAT

200' Ft. from N. Line

_____ Ft. from S. Line

200' Ft. from E. Line

_____ Ft. from W. Line

			○

Location _____

Rig up _____

Drilling and Remarks:

R.O. G

RECORD

Cased _____ in., _____ ft.

Sand _____

Gas _____

Oil _____

Total Depth _____

PRODUCTION

1st 24 hrs. Nat. _____

1st 24 hrs. after shot _____

Gas _____ Cu. Ft.

Dry Hole _____

Abandoned _____

Date

MAR 14 1924

M. A. BENEAR

192

Scout

Map No. **KANSAS** Sec. 7 Twp. 20 R. 6W

Well No. #1 Bush
Kuma Oil Co Company

Contractor

ABANDONED SECTION PLAT

200' Ft. from N. Line

_____ Ft. from S. Line

200' Ft. from E. Line

_____ Ft. from W. Line

			0

Location _____

Rig up _____

Drilling and Remarks:

2049
35651

RECORD

Cased _____ in., _____ ft.

Sand _____

Gas _____

Oil _____

Total Depth _____

PRODUCTION

1st 24 hrs. Nat. _____

1st 24 hrs. after shot _____

Gas _____ Cu. Ft.

Dry Hole _____

Abandoned _____

Date

1/21 192 5 M. A. BENEAR Scout

MAP No. KANSAS SEC. 7 TWP. 20S R. 6W

WELL No. 1 Bush

Cameron - Cora COMPANY

CONTRACTOR

SECTION PLAT

ABANDONED

FT. FROM N. LINE

FT. FROM S. LINE

FT. FROM E. LINE

FT. FROM W. LINE

O.K.

LOCATION

RIG UP

DRILLING AND REMARKS:

*check
with our
map*

RECORD

CASED IN. FT.

SAND

GAS

OIL

TOTAL DEPTH 3565

PRODUCTION

1ST 24 HRS. NAT.

1ST 24 HRS. AFTER SHOT

GAS Cu. Ft.

DRY HOLE ✓

ABANDONED ✓

DATE

11/15 192 ✓ SCOUT