


Map No. **KANSAS** Sec. 7 Twp. 20 R. 9W

Well No. 1 Foote Farm _____
Continental Company

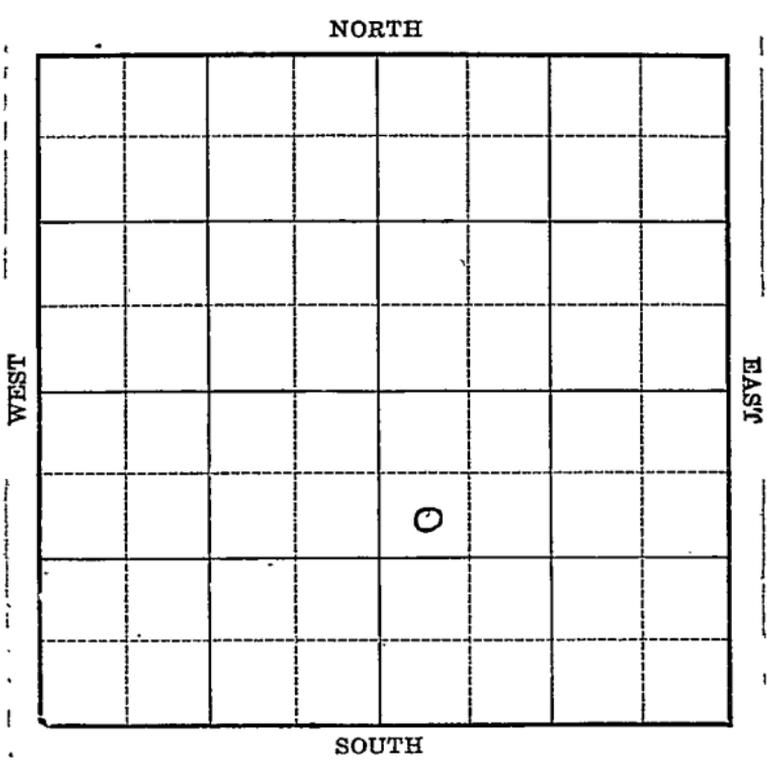

Location _____

Drilling Remarks _____

Rig Up _____

Drilling Remarks _____

RECORD

Cased _____ in. _____ ft.

Sand _____

Gas _____

Oil _____

Total Depth _____

PRODUCTION

1st 24 hrs. Nat. _____

1st 24 hrs. after shot _____

Gas _____ cu. ft.

Dry Hole _____

Abandoned _____

Rice

Map No. KANSAS Sec. 7 Twp 20 R. 9^W

Well No. 1 G oote Farm


Continental Company

990 Ft. from N. Line

_____ Ft. from S. Line

_____ Ft. from E. Line

350 Ft. from W. Line

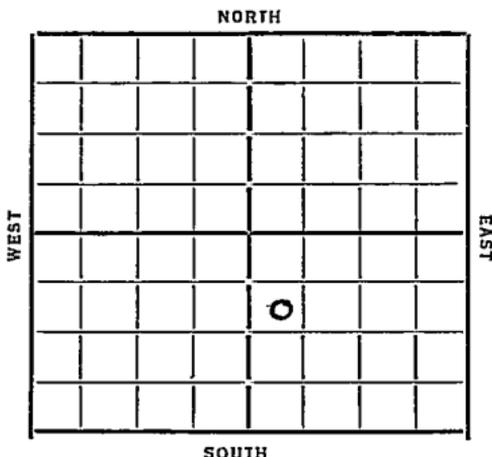

Date
1934

REPORT

<u>2/21</u>	<u>Location</u>
<u>3/1</u>	<u>Rigging Rotary</u>
<u>3/8</u>	<u>Dily 900</u>
<u>3/15</u>	<u>" 2575 12" at 205</u>
<u>3/22</u>	<u>" 3000</u>
<u>3/29</u>	<u>Siliceous 3278 TD 3279 Rust</u>
<u>4/5</u>	<u>7" 3279 1700' Oil 40 Min</u>
	<u>9A 3285 3000' oil swabbing</u>
<u>4/18</u>	<u>Siliceous 3278 TD 3288</u>
	<u>943 BBlk 23 hrs Natural</u>

COMPLETED

Map No. 49 Sec. 7 Twp. 20 R. 9W

Well No. 1- Foote

Continental Company

FIRST REPORT Contractor

SECTION PLAT

990 Ft. from N. Line

..... Ft. from S. Line

..... Ft. from E. Line

330 Ft. from W. Line

		o	

Location

Rig up.....

Drilling and Remarks:

RECORD

Cased..... in., ft.

Sand.....

Gas.....

Oil.....

Total Depth.....

PRODUCTION

1st 24 hrs. Nat.....

1st 24 hrs. after shot.....

Gas..... Cu. Ft.

Dry Hole.....

Abandoned.....

Date

2-21-34 192 O. Mammuch Scout

Map No. 49 Sec. 7 Twp. 20 R. 9W

Well No. 1-1100

Continental Oil Company

Contractor

COMPLETED

SECTION PLAT

		0	

990 Ft. from N. Line

_____ Ft. from S. Line

_____ Ft. from E. Line

330 Ft. from W. Line

Location _____

Rig up _____

Drilling and Remarks:

943 lbs
23 hrs
natural

RECORD

Cased _____ in., _____ ft.

Sand silicas 3278

Gas _____

Oil _____

Total Depth 3288

PRODUCTION

1st 24 hrs. Nat. _____

1st 24 hrs. after shot _____

Gas _____ Cu. Ft.

Dry Hole _____

Abandoned _____

Date

4-18-34₁₉

ORVAL MANNSCHRECK

Scout