KANSAS


Form 51—5M—7-39—Palace

McPherson

Section 7 Township 20 Range 5-W

Well No. #1 McMillan

Company Republic Nat. Gas.

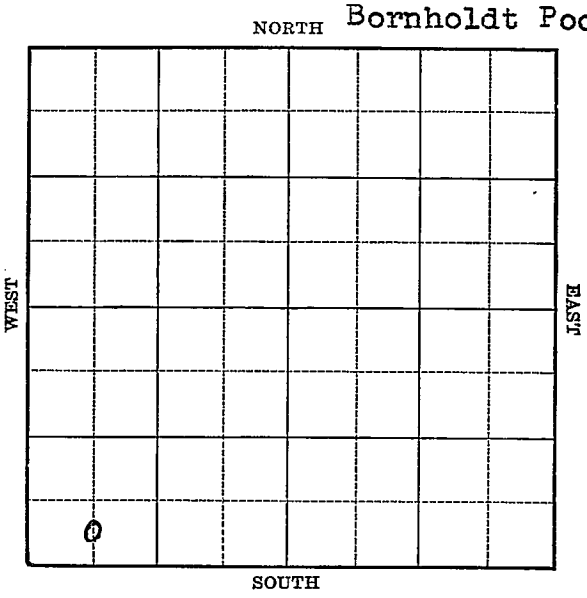

FORM 252-A 5M KANSAS McPherson

Sec. 7 Twp. 20 R. 5-W

Well No. #1 McMillan Farm

Republic Nat. Gas Company


(Bornholdt)

_____ Ft. from N. Line

330 Ft. from S. Line

_____ Ft. from E. Line

660 Ft. from W. Line

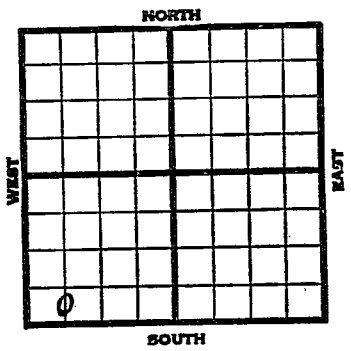

Elev. 1562

1940	REPORT
1/10	Location
1/18	R.U. Rotary.
1/25	10" - 155' Drlg. 1650'
2/1	Drlg. 3050'
2/8	Top Chat 3313 Very little oil 3349
	Small Inc. 3352 Pay 3352-66 TD
	Flow 75 bbls. per hr. for 2½ hrs. thru
	csg. S.D. to run tubing (Tel)
	7" - 3315'
2/21	Chat. 3313'
	7" - 3315'
	T.D. 3366'
	Bottom hole bomb potential
	13,966 bbls.
	Maximum 3000 bbls.
	COMPLETED

Form 26—1M Bks.—2-29 McPherson KANSAS

Map No. 48 Sec. 7 Twp. 20 R. 5W

Well No. 1 McMillan

Republic Nat. Gas Company

Contractor

FIRST REPORT

C S L SW SW


Ft. from N. Line

330 Ft. from S. Line

Ft. from E. Line

660 Ft. from W. Line

SECTION PLAT

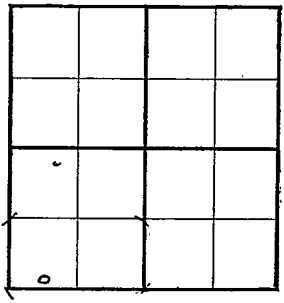

BORNHOLDT POOL

Location X

Rig up

Drilling and Remarks:

RECORD

Cased in., ft.

Sand

Gas

Oil

Total Depth

PRODUCTION

1st 24 hrs. Nat.

1st 24 hrs. after shot

Gas Cu. Ft.

Dry Hole

Abandoned

Date

JAN 10 1940 19 S. J. LEWIS Scout

Form 26—1M Bks.—2-29 McPherson KANSAS

Map No. 48 Sec. 7 Twp. 20 R. 5W

Well No. 1 McMillan

Republic Nat. Gas Company

Contractor

COMPLETED

C S L SW SW

Ft. from N. Line


330 Ft. from S. Line

Ft. from E. Line

660 Ft. from W. Line

BORNHOLDT POOL

SECTION PLAT

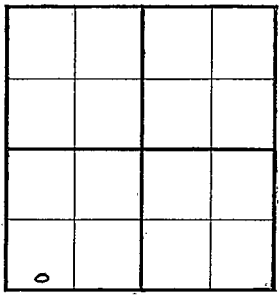

Location

Rig up

Drilling and Remarks:

Okla 3313

7" @ 3315.

Bottom Hole Bom

Pbd 13966

Maximum 300

RECORD

Cased in., ft.

Sand

Gas

Oil

Total Depth 3366

PRODUCTION

1st 24 hrs. Nat.

1st 24 hrs. after shot

Gas Cu. Ft.

Dry Hole

Abandoned

Date

FEB 21 1940 19

S. J. LEWIS, Scout