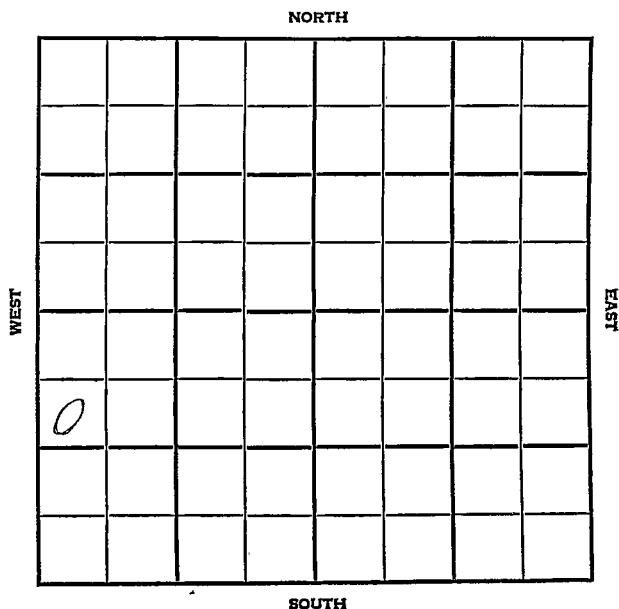


Section 7 Township 20 Range 5WWell No. #1 McMillanCompany Audley Ogden (Hutchinson)

Date Comm. spd. 10-26-56	Sec.
8" @ 182 w/125. Drlg. 2500	

2014. 11. 18
2014

County McPherson Elev. 1569 Co. 1
 Sec. 7 Twp. 20 Rge. 5W
 Company Audley Ozden (Hutchinson)
 Farm Name McMillen No. 1

TOPS	DEPTH	LOG	DATUM	Loc. in Sec.
Anb.				SW NW SW
TP.				
H.				
Tr.				
Dg.				
BL				
L.				
K.C.				Geol.
B.K.C.				Contr.
Ce.				Sierra Tools
C.				
M. <u>Chat</u>	<u>3225</u>			Pool
M.				Bornhold
K.				
Mz.				
Me.				
V.				
S.				
S.				
A.				
R.				
PE.				
G.				
T.D.	<u>3399</u>			

COMPLETE

Date Comm. spd. 10-26-56

8" @ 182 w/125, Drlg. 2500 NOV 7 '56

9 1/2 3398 NOV 13 '56 NOV 21 '56 MICT

NOV 28 '56 DEC 5 '56 DD 3416 TP

Frac \$ 42 B o no/w 3 hrs

P. 25 B o p d no/w to.