


Rice

Form 51-5M-5-34-Palace

Map No. **KANSAS** Sec. 7 Twp. 20 R. 9W

Well No. Sharp Farm
Sinclair - Prairie Company

NORTH

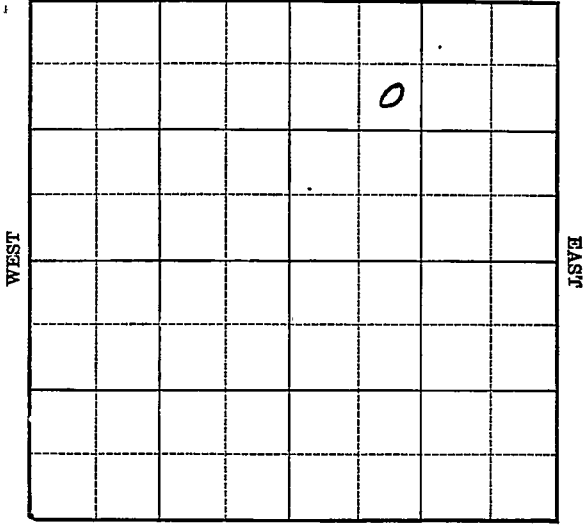

SOUTH

Location _____

Drilling Remarks _____

Rig Up _____

Drilling Remarks _____

RECORD

Cased _____ in. _____ ft.

Sand _____

Gas _____

Oil _____

Total Depth _____

PRODUCTION

1st 24 hrs. Nat. _____

1st 24 hrs. after shot _____

Gas _____ cu. ft.

Dry Hole _____


Abandoned _____

Rice

Map No. KANSAS Sec. 7 Twp 20 R. 9W

Well No. 1 Sharp Farm _____
Sinclair - Prairie Company _____

990 Ft. from N. Line
____ Ft. from S. Line
____ Ft. from E. Line
990 Ft. from W. Line

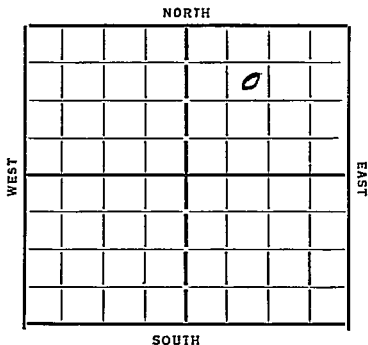

Date 1934

REPORT

6/13 Moving in
6/21 _____
6/28 Material
7/5 Rig up
7/12 Dlg 1919
7/19 No. 3085 Dlg 3213
7/26 T Del 3255 8" 3261
8/2 TD 3325 PB 3312 acidizing
8/9 No test
8/15 Top Siliceous 3255
T.D. 3325
P.B. to 3312
1000 gallon acid
86 Bbls oil
some water

COMPLETED

KANSAS

Map No. 49 Sec. 7 Twp. 20 R. 9W

Well No. 1 - Sharp

Inclis-prairie Company

Contractor

FIRST REPORT

SECTION PLAT

		O	

990 Ft. from N. Line

_____ Ft. from S. Line

_____ Ft. from E. Line

990 Ft. from W. Line

Location _____

Rig up _____

Drilling and Remarks:

moving in

RECORD

Cased _____ in., _____ ft.

Sand _____

Gas _____

Oil _____

Total Depth _____

PRODUCTION

1st 24 hrs. Nat. _____

1st 24 hrs. after shot _____

Gas _____ Cu. Ft.

Dry Hole _____

Abandoned _____

Date

ORVAL MANNSCHECK

6-13-37 19

Scout

Map No. 49 Sec. 7 Twp. 20 R. 9W

Well No. 1 - Sharp

Sinclair-Prairie Company
Contractor

COMPLETED

SECTION PLAT

		8	

990 Ft. from N. Line

_____ Ft. from S. Line

_____ Ft. from E. Line

990 Ft. from W. Line

Location _____

Rig up _____

Drilling and Remarks:

P. B. 3312
1000 gal acid
86 lbs acid
some water

RECORD

Cased _____ in., _____ ft.

Sand Aluceros 3255

Gas _____

Oil _____

Total Depth 3325

PRODUCTION

1st 24 hrs. Nat. _____

1st 24 hrs. after shot _____

Gas _____ Cu. Ft.

Dry Hole _____

Abandoned _____

Date

ORVAL MANNSCHRECK

8-15-31₁₉

Scout