


Rice

Form 51-5M-11-31-Palace

Map No. **KANSAS** Sec. 7 Twp. 20 R. 9W

Well No. 1 Mc Farland Farm
Texas Co. Company

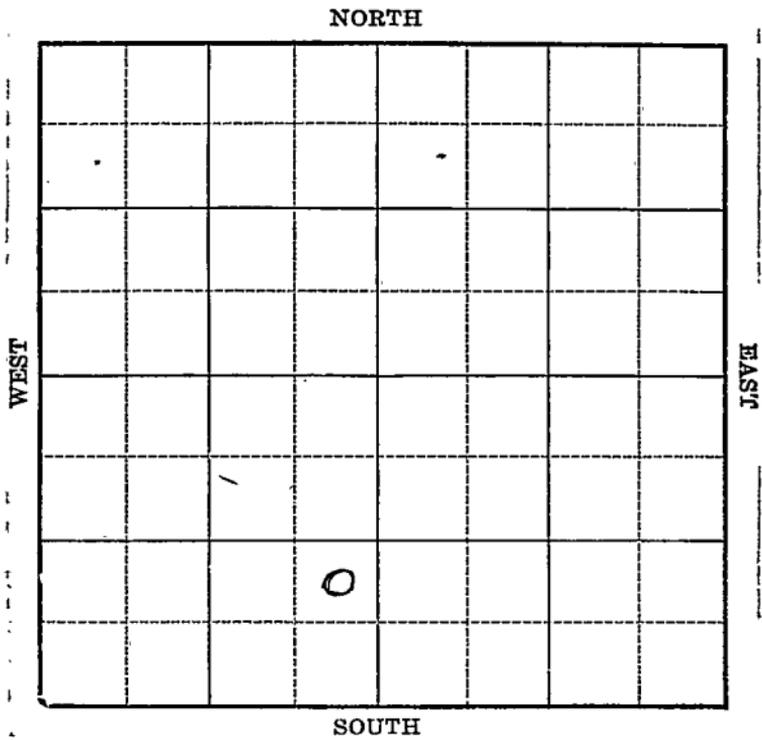

Location _____

Drilling Remarks _____

Rig Up _____

Drilling Remarks _____

RECORD

Cased _____ in. _____ ft.

Sand _____

Gas _____

Oil _____

Total Depth _____

PRODUCTION

1st 24 hrs. Nat. _____

1st 24 hrs. after shot _____

Gas _____ cu. ft.

Dry Hole _____

Abandoned _____

Rice

Map No. KANSAS Sec. 7- Twp 20 R. 9W


Well No. 1 Mc Garland Farm
Texaco Co. Company

 Ft. from N. Line

990 Ft. from S. Line

330 Ft. from E. Line

 Ft. from W. Line

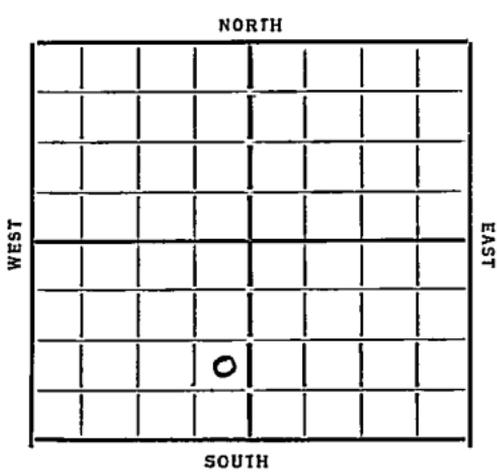

Date
1934

REPORT

2/14 Bldg Rig
2/23 Rotary Rig
3/1 12" at 200
3/8 Drlg 2080
3/15 " 2445
3/22 " 3040
3/29 Siliceous 3275 8" 3275
Rust
4/5 —
4/12 TD 3291 1200 oil Tubing
to acidize
4/19 1000 Gal acid 200 Bbls 6 hrs.
4/26 Pump 897 oil 18 hrs.
5/2 Siliceous 3275 TD 3291
1093 Bbls.

COMPLETED

Map No. 49 Sec. 11 Twp. 20 R. 9W

Well No. 1-McFarland

Texas Co Company

Contractor

FIRST REPORT

SECTION PLAT

Ft. from N. Line

990 Ft. from S. Line

330 Ft. from E. Line

Ft. from W. Line

Location

Rig up

Drilling and Remarks:

B. Rig.

RECORD

Cased _____ in., _____ ft.

Sand _____

Gas _____

Oil _____

Total Depth _____

PRODUCTION

1st 24 hrs. Nat. _____

1st 24 hrs. after shot _____

Gas _____ Cu. Ft.

Dry Hole _____

Abandoned _____

Date

2-14-34 192 *Omannschub* Scott

Map No. 49 Sec. 7 Twp. 20 R. 9W

Well No. McFarland
Texas Co Company

Contractor

SECTION PLAT

CORRECTION

Ft. from N. Line

990 Ft. from S. Line

330 Ft. from E. Line

Ft. from W. Line

CORRECTION

Location.....

Rig up.....

Drilling and Remarks:

*Bed. Rig
Formerly reported
in Sec. 11*

CORRECT

RECORD

Cased.....in.,ft.

Sand.....

Gas.....

Oil.....

Total Depth.....

PRODUCTION

1st 24 hrs. Nat.

1st 24 hrs. after shot.....

Gas.....Cu. Ft.

Dry Hole.....

Abandoned.....

Date

2-16-34

192

O. Manschuck
Scout

