


Section 7 Township 20 Range 9-W

Well Number 1 - Wickerham

Company Sacco Oil

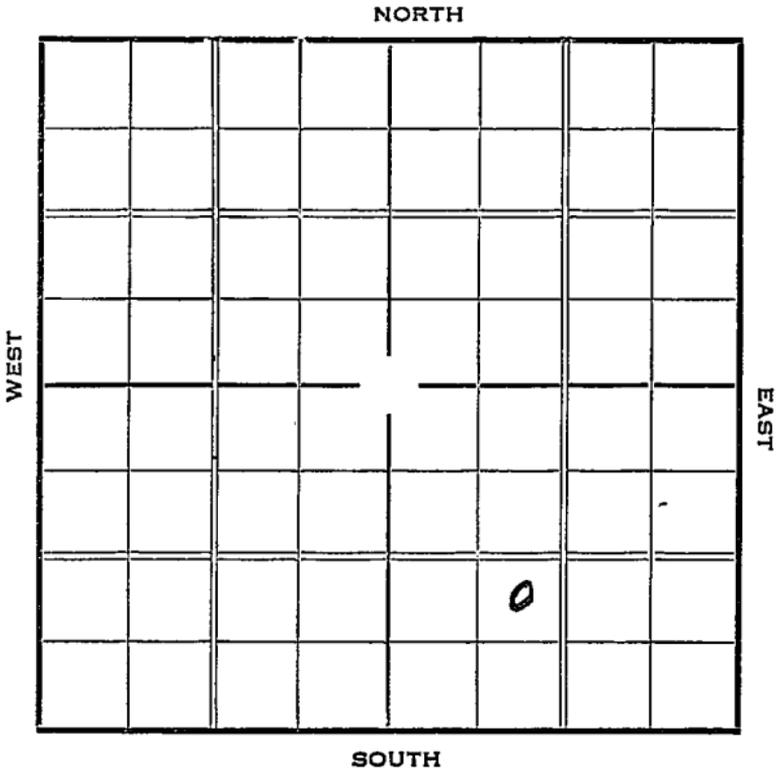

Sec. 7 Twp. 20- R. 9-W

Well No. #1 Wickerham Farm
Sacco Oil Company


 Ft. from N. Line

990 Ft. from S. Line

 Ft. from E. Line

990 Ft. from W. Line

Elev. 1763

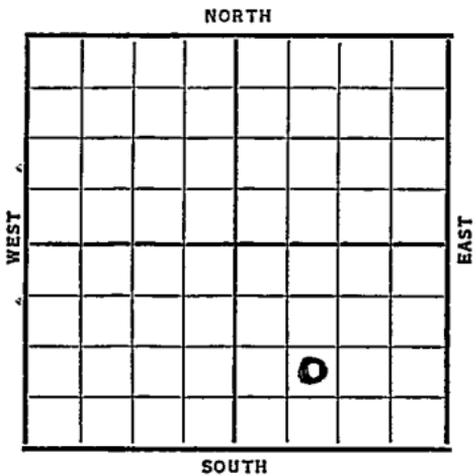

Date	REPORT
1937	
7/14	Cable rig.
7/23	" "
7/30	Rigged up & SD.
8/6	15" @ 154'. Drlg. 420'.
8/13	12" @ 875'. Drlg. 1140'.
8/20	SD 1175'.
8/28	" "
9/3	10" @ 1815'. T.D. 1855'. C.O.
9/10	" " " " "
9/17	10" @ 2250'. 8" @ 2545'.
	Drlg. 2610'.
9/24	Drlg. 2835'.
	OVER

1937

9/29

6" @ 3298'.

Sil. 3298'.

T.D. 3340'.

No shows reported.

~~ABANDONED~~

Rice KANSAS

Map No. _____ Sec. 7 Twp. 20 R. 9 WWell No. 1 - WickerhamSacco Oil Company_____
Contractor

FIRST REPORT

100 Ft. from N. Line990 Ft. from S. Line

_____ Ft. from E. Line

990 Ft. from W. Line

SECTION PLAT

		0	

Location _____

Rig up _____

Drilling and Remarks:

Cable Rig

RECORD

Cased _____ in., _____ ft.

Sand _____

Gas _____

Oil _____

Total Depth _____

PRODUCTION

1st 24 hrs. Nat. _____

1st 24 hrs. after shot _____

Gas _____ Cu. Ft.

Dry Hole _____

Abandoned _____

Date

JUL 1 - 1921 19H. D. Hatfield Scout

Rice **KANSAS**

Map No. 2 Sec. 7 Twp. 20 R. 9W

Well No. 1-Wickerham

Sacco Oil Company

Contractor

ABANDONED

SECTION PLAT

M NE SW SE
 Ft. from N. Line
990 Ft. from S. Line
 Ft. from E. Line
990 Ft. from W. Line

		0	

Location _____

Rig up _____

Drilling and Remarks:

no Shows Reported

DVA

RECORD

Cased 6 in., 3298 ft.

~~Sand~~ 511 3298

Gas _____

Oil _____

Total Depth 3340

PRODUCTION

1st 24 hrs. Nats: _____

1st 24 hrs. after shot _____

Gas _____ Cu. Ft.

Dry Hole _____

Abandoned _____

Date

SEP 29 1937 19

H. D. Hatfield Scout