


Map No. KANSAS Sec. 7 Twp. 20 R. 1W

Well No. 1- Meeks Farm
Washoma & Shell Pet Company

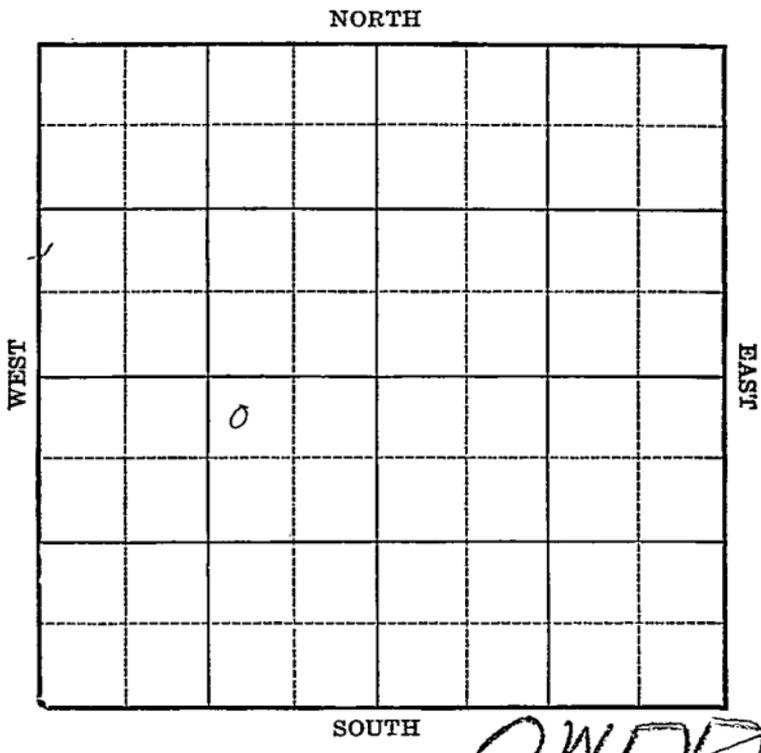

Location _____
Drilling Remarks _____

Rig Up _____
Drilling Remarks _____

RECORD

Cased _____ in. _____ ft.
Sand _____
Gas _____
Oil _____
Total Depth _____


PRODUCTION

1st 24 hrs. Nat. _____
1st 24 hrs. after shot _____
Gas _____ cu. ft.
Dry Hole _____
Abandoned _____

Map No. KANSAS Sec. 7 Twp. 20 R. 1^w

Well No. 1-Weeks Farm
Washoma & Shee Company

NORTH

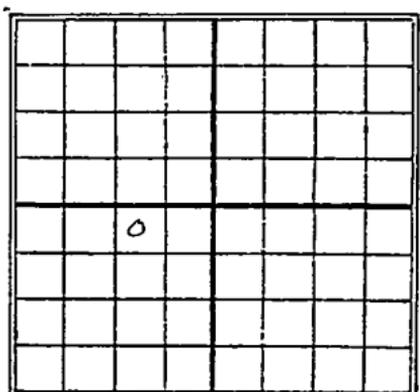

300 Ft. from N. Line

_____ Ft. from S. Line

1020 Ft. from E. Line

_____ Ft. from W. Line

1930

O.W.D.D. SOUTH

Date	REPORT
11/5	Pos.
11/12	Big
11/19	Run up
11/25	Dreg. 460'
12/3	" 870'
12/10	" 1520
12/17	" 2100'
12/23	" 2235'
12/30	T.D. 2235 SID for 10"
1931	
1/7	10"-2420
"	Dreg 2445
1/14	" 2595
1/21	8"-2645 Clog out
1/28	Chat 2926
	T.D. 2935 set 6"
	P.B.P.
2/4	T.D. 2966 bldg tanks
2/11	Chat 2926-76
	T.D. 2976
	swab 9/8 bbl set
	Comp

(over)

1931

OWDD

4/29-

Old T.D. 2976

Drilled to

TD. 2977 1/2'

Swab 150 bbl 3 hr

Will deepen

5/6-

Old T.D. 2976

Drilled to

TD. 2982

Potential gauge

1850 bbls oil

2% water

Comp.

OWDD

1933

4/5-

OWDD.

Drilling 3015

4/12 drlg 3159'

4/19 5"-3181 B.L. 3189' drlg 3200'

4/26 drlg on W.R. Lugs 3397'

5/4 Top Viola 3403 1st air 3406

drlg 3438 - 2000' air in hole

5/10 Base Viola 3445 Top Wilcox 3450

J.R. 3457' 500' coated P.B. to 3437'

3437 Cement 5" 3397'

5/17-

5/24- Sand Viola 3403-45

Top Wilcox 3450

P.B. 3437

1000 Gallon acid

Pump 250 bbls oil

17 bbls water

(Completed)

M. Person
 Map No. **KANSAS** Sec. 7 Twp. 20 R. 1W

43
 Well No. 1 Weeks

Washona & Shell Co. Company

Contractor


SECTION PLAT

300 Ft. from N. Line

..... Ft. from S. Line

1020 Ft. from E. Line

..... Ft. from W. Line

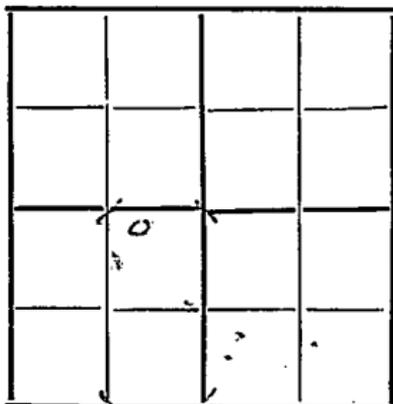

FIRST REPORTS

Location.....

Rig up.....

Drilling and Remarks:

ROY

RECORD

Cased..... in., ft.

Sand.....

Gas.....

Oil.....

Total Depth.....

PRODUCTION

1st 24 hrs. Nat.....

1st 24 hrs. after shot.....

Gas..... Cu. Ft.

Dry Hole.....

Abandoned.....

Date

NOV 5 1930

S. J. LEWIS Scout

Map No. KANSAS Sec. 7 Twp. 20 R. 14W

Well No. 43 1 Meeks

Washburn & Shell Oil Company

Contractor

SECTION PLAT


200 Ft. from N. Line

..... Ft. from S. Line

1020 Ft. from E. Line

..... Ft. from W. Line

COMPLETED

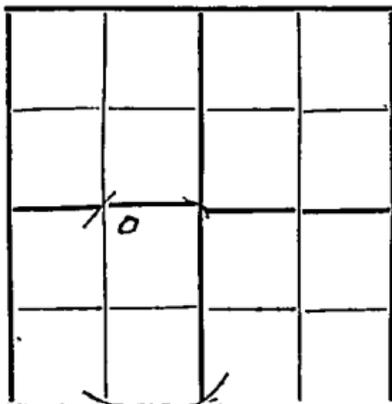

Location.....

Rig up.....

Drilling and Remarks:

swab 915 ft

RECORD

Cased..... in., ft.

Sand 2926 - 76

Gas.....

Oil.....

Total Depth 2976

PRODUCTION

1st 24 hrs. Nat.....

1st 24 hrs. after shot.....

Gas..... Cu. Ft.

Dry Hole.....

Abandoned.....

Date

FEB 1 1 1931

S. J. LEWIS

Scout

M. Pherson

Map No. **KANSAS** Sec. *7* Twp. *20* R. *1* ^W

43
Well No. *1* *Meeks*

Woshoma & *Shell* Company

Contractor

FIRST REPORTS

300 Ft. from N. Line


..... Ft. from S. Line

1020 Ft. from E. Line

..... Ft. from W. Line

"
Old well Deeper

SECTION PLAT

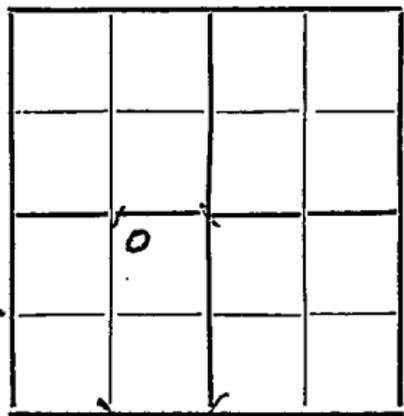

Location.....

old JD 2976
Rig up.....

Drilling and Remarks: ..

Drilled to 2977 1/2

Run 150 Bls 3 hours

Will Deepen.

RECORD

Cased.....in.,ft.

Sand.....

Gas.....

Oil.....

Total Depth.....

PRODUCTION

1st 24 hrs. Nat.....

1st 24 hrs. after shot.....

Gas..... Cu. Ft.

Dry Hole.....

Abandoned.....

Date

APR 29 1931

CHAS. L. SHERWOOD
192.....Scout

43 KANSAS

McPherson

Map No. _____ Sec. 7 Twp. 20 R. 1 ^W

Well No. 1 *Meeks*

Washington & Shell Company

Contractor _____

COMPLETED

300 Ft. from N. Line

_____ Ft. from S. Line

1070 Ft. from E. Line

_____ Ft. from W. Line

SECTION PLAT

<i>DWD</i>			
0			

Location _____

Rig up _____

Drilling and Remarks:

Potential
1850 Bbls.
2% water.

RECORD

Cased _____ in., _____ ft.

Sand _____

Gas _____

Oil _____

Total Depth 2982

PRODUCTION

1st 24 hrs. Nat. _____

1st 24 hrs. after shot _____

Gas _____ Cu. Ft.

Dry Hole _____

Abandoned _____

Date

MAY 7 1931

CHAS. L. SHERWOOD

Mc Pherson

W

43 KANSAS

Map No. _____ Sec. *7* Twp. *20* R. *1*

Well No. *1* *Meers*

Nashoma & Shee Company

Contractor

FIRST REPORTS

300 Ft. from N. Line

_____ Ft. from S. Line

1070 Ft. from E. Line

_____ Ft. from W. Line

SECTION PLAT

<i>"OR D"</i>			
	<i>o</i>		

Location _____

Rig up _____

Drilling and Remarks *Old -*

By 3015

RECORD

Cased _____ in., _____ ft.

Sand _____

Gas _____

Oil _____

Total Depth *2987*

PRODUCTION

1st 24 hrs. Nat. _____

1st 24 hrs. after shot _____

Gas _____ Cu. Ft.

Dry Hole _____

Abandoned _____

Date

APR 5 1933 CHAS. L. SHERWOOD

192

Scout

McPherson W

KANSAS

Map No. _____ Sec. 7 Twp. 30 R. 1

Well No. 1 *Meeks*

Washoma & Dheel Company

Contractor

SECTION PLAT

	0		

COMPLETED

300 Ft. from N. Line

_____ Ft. from S. Line

1020 Ft. from E. Line

_____ Ft. from W. Line

Location _____

Rig up _____

Drilling and Remarks:

Top Meeks 3450
P.B. 3437
1000 gal and
Pump 250 Bls Oil
17 Bls Water

RECORD

Cased _____ in _____ ft.

Sand *Viola 3403-45*

Gas _____

Oil _____

Total Depth 3457 *Water*

PRODUCTION

1st 24 hrs. Nat. _____

1st 24 hrs. after shot _____

Gas _____ Cu. Ft.

Dry Hole _____

Abandoned _____

Date

MAY 24 1933

CHAS. L. SHERWOOD

192

Scout