


Map No. KANSA Sec. 7 Twp. 20 R. 9W  
 Well No. 2 Sharp Farm  
Lincoln - Prairie Company

NORTH

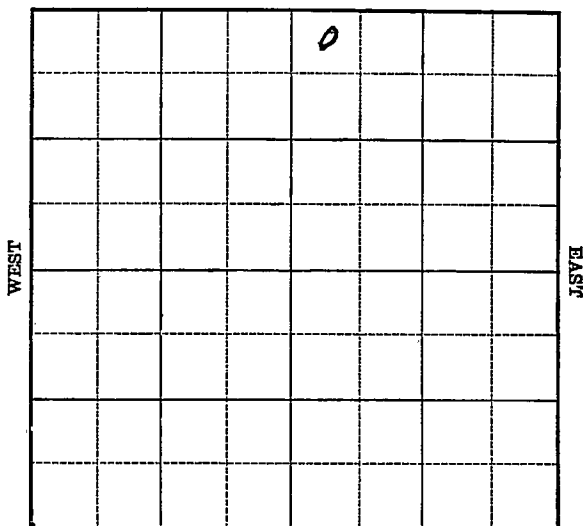

SOUTH

Location \_\_\_\_\_  
 Drilling Remarks \_\_\_\_\_

Rig Up \_\_\_\_\_  
 Drilling Remarks \_\_\_\_\_

## RECORD

Cased \_\_\_\_\_ in. \_\_\_\_\_ ft.  
 Sand \_\_\_\_\_  
 Gas \_\_\_\_\_  
 Oil \_\_\_\_\_  
 Total Depth \_\_\_\_\_

## PRODUCTION

1st 24 hrs. Nat. \_\_\_\_\_  
 1st 24 hrs. after shot \_\_\_\_\_  
 Gas \_\_\_\_\_ cu. ft.  
 Dry Hole \_\_\_\_\_  
 Abandoned \_\_\_\_\_

Rice

Map No. KANSAS Sec. 7 Twp. 20 R. 9W

Well No. 7 Sharp Farm  
Sinclair - Prairie Company

NORTH

330 Ft. from N. Line

\_\_\_\_\_ Ft. from S. Line

\_\_\_\_\_ Ft. from E. Line

330 Ft. from W. Line

|  |  |  |  |  |  |  |  |  |  |
|--|--|--|--|--|--|--|--|--|--|
|  |  |  |  |  |  |  |  |  |  |
|  |  |  |  |  |  |  |  |  |  |
WEST

EAST

SOUTH

Date

REPORT

1935  
2/6 Location  
2/14 Material  
2/21 Rgn  
2/28 Dlg 1418 17" 161  
3/7 " 3153  
3/14 6" 3230 Rust  
3/21 Simp 3248 Sil 3253  
T17 3267 front 292 Bbls 12 hrs.  
3/28 1000 acid  
4/3 Siliceous 3253  
T17 3267  
1000 acid  
643 Bbls.

COMPLETED

KANSAS

Form 26-1M Bks. 9-28

Map No. 49 Sec. 7 Twp. 20 R. 9WWell No. 2-SharpSunclair-Prairie Company

Contractor

FIRST REPORTS

SECTION PLAT

330 Ft. from N. Line

Ft. from S. Line

Ft. from E. Line

330 Ft. from W. Line

|  |  |   |  |
|--|--|---|--|
|  |  | 0 |  |
|  |  |   |  |
|  |  |   |  |
|  |  |   |  |
|  |  |   |  |

Location

Rig up

Drilling and Remarks:

## RECORD

Cased.....in., .....ft.

Sand.....

Gas.....

Oil.....

Total Depth.....

## PRODUCTION

1st 24 hrs. Nat.....

1st 24 hrs. after shot.....

Gas.....Cu. Ft.

Dry Hole.....

Abandoned.....

Date

2-6-35

192

ORVAL MANNSCHRECK

Scout

Map No. 49 Sec. 7 Twp. 20 R. 9W

Well No. 2 - Sharpe

Sinclair Prairie Company

Contractor

**COMPLETED**

**SECTION PLAT**

330 Ft. from N. Line

..... Ft. from S. Line

..... Ft. from E. Line

330 Ft. from W. Line

|  |  |   |  |
|--|--|---|--|
|  |  | 0 |  |
|  |  |   |  |
|  |  |   |  |
|  |  |   |  |
|  |  |   |  |

Location .....

Rig up .....

Drilling and Remarks:

1000 and

643 bbls

**RECORD**

Cased ..... in., ..... ft.

Sand silicious 3253

Gas .....

Oil .....

Total Depth 3267

**PRODUCTION**

1st 24 hrs. Nat. ....

1st 24 hrs. after shot .....

Gas ..... Cu. Ft.

Dry Hole .....

Abandoned .....

Date

4-3-35 192

**ORVAL MANNSCHRECK**

Scout