


Rice 9W

Map No. KANSAS Sec 7 Twp. 20 R. 9W

Well No. 27 Footley Lurio Oil & Gas Farm Company

NORTH

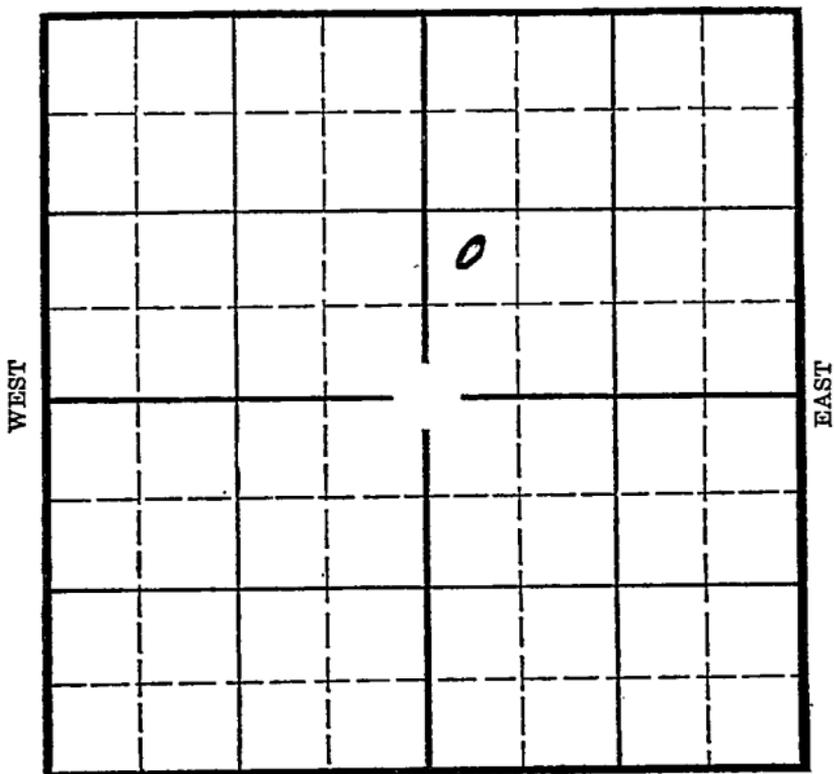

SOUTH

Location _____
Drilling Remarks _____

Rig Up _____
Drilling Remarks _____

RECORD

PRODUCTION

Cased _____ in. _____ ft.
 Sand _____
 Gas _____
 Oil _____
 Total Depth _____


1st 24 hrs. Nat. _____
 1st 24 hrs. after shot _____
 Gas _____ cu. ft. _____
 Dry Hole _____
 Abandoned _____

Rice

Map No. KANSAS Sec. 7 Twp. 20 R. 9W

Well No. 2 Foote Farm _____
Lario Oil & Gas Company

_____ Ft. from N. Line
990 Ft. from S. Line
_____ Ft. from E. Line
330 Ft. from W. Line

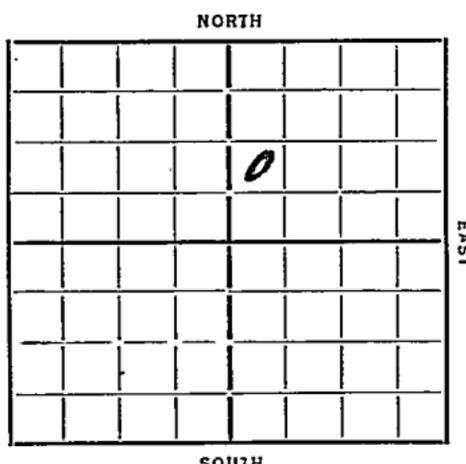

Elev. 1746

Date	REPORT
6/5	Location
6/13	Allow
6/20	Rig
6/28	Spud
7/3	Relg 1010 20" 162
7/11	1808 run 10"
7/18	2175 WR 10" 10" 2262
8/8	Relg 2580 8" 2512
8/15	HW 2725 WR 8" 2742
8/22	Relg 2781
8/29	8" 2785 Log 2930
9/6	3060 WR 8"
9/25	TD 3282
	727 Hrs 19 hrs.
	COMPLETED

Map No. 49 Sec. 7 Twp. 20 R. 9W

Well No. 2-Fronte

Lario oil & Gas Company

Contractor

FIRST REPORTS

..... Ft. from N. Line

990 Ft. from S. Line

..... Ft. from E. Line

330 Ft. from W. Line

SECTION PLAT

		o	

Location

Rig up.....

Drilling and Remarks:

RECORD

Cased..... in., ft.

Sand.....

Gas.....

Oil.....

Total Depth.....

PRODUCTION

1st 24 hrs. Nat.....

1st 24 hrs. after shot.....

Gas..... Cu. Ft.

Dry Hole.....

Abandoned.....

Date

6-5-35

192.....

ORVAL MANNSCHRECK

Scout

Map No. 249 Sec. 7 Twp. 20 R. 9W

Well No. 2-Porte

Lario Oil & Gas Company

Contractor

COMPLETED

SECTION PLAT

		0	

..... Ft. from N. Line

990

..... Ft. from S. Line

..... Ft. from E. Line

330

..... Ft. from W. Line

Location.....

Rig up.....

Drilling and Remarks:

727 bbls

19 hrs

RECORD

Cased..... in., -..... ft.

Sand.....

Gas.....

Oil.....

Total Depth 3282

PRODUCTION

1st 24 hrs. Nat.....

1st 24 hrs. after shot.....

Gas..... Cu. Ft.

Dry Hole.....

Abandoned.....

Date

9-25-35 192

W. J. WAINSCHECK Scout