

Rice

Form 252-A
5M 4-32 MPC

Map No. KANSAS Sec. 7 Twp 20 R. 9^w


Well No. 3 Mc Farland Farm
Texas Co. Company

_____ Ft. from N. Line

330 Ft. from S. Line

330 Ft. from E. Line

_____ Ft. from W. Line

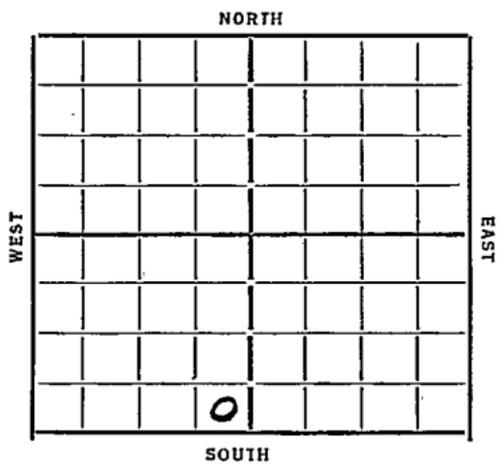

Date 7/24

REPORT

5/16 Bldg Rig
5/25 Rign up
5/31 Dlg 361
6/7 " 2226
6/14 " 3295
6/21 Siliceous 3296 Rust
6/28 Dlg plug
7/5 3321 TD 5.0. + w. acidizing
7/12 No test
7/19 5 oil + 5 w. Dlg 3346 1/2
 1500' w 5D
7/26 PB 3342 shot 10 + 20 gts
8/1 Siliceous 3297 TD 3346 1/2
 PB 3342 1000 acid shot 10 gts
 D + A

ABANDONED

Map No. 49 Sec. 7 Twp. 20 R. 9W

Well No. 3-McParland

Texas Company

Contractor

FIRST REPORTS

SECTION PLAT

_____ Ft. from N. Line

330 Ft. from S. Line

330 Ft. from E. Line

_____ Ft. from W. Line

1	0		

Location _____

Rig up _____

Drilling and Remarks:

Best Rig

RECORD

Cased _____ in., _____ ft.

Sand _____

Gas _____

Oil _____

Total Depth _____

PRODUCTION

1st 24 hrs. Nat. _____

1st 24 hrs. after shot _____

Gas _____ Cu. Ft.

Dry Hole _____

Abandoned _____

Date

5-16-34 19

ORVAL MANNSCHRECK Scout

Map No. 49 Sec. 7 Twp. 20 R. 9W

Well No. 3-McFarland

Texas Co Company

Contractor

ABANDONED

SECTION PLAT

_____ Ft. from N. Line

330 Ft. from S. Line

330 Ft. from E. Line

_____ Ft. from W. Line

Location _____

Rig up _____

Drilling and Remarks:

PB 3342
1000 acid
shot 10 fts

NVA

RECORD

Cased _____ in., _____ ft.

Sand siliceous 3297

Gas _____

Oil _____

Total Depth 3346 1/2

PRODUCTION

1st 24 hrs. Nat. _____

1st 24 hrs. after shot _____

Gas _____ Cu. Ft.

Dry Hole _____

Abandoned _____

Date

8-1-37 19

ORVAL MANNSCHECK

Scout