

Rice
20

KANSAS

8W ✓

Sec. 28 Twp. R.

Well No. #1 Yeast Farm

Brunson Drlg. Company

Brunson Drlg. Contractor

Wildcat

Ft. from N. Line

660'


Ft. from S. Line

330'

Ft. from E. Line

Ft. from W. Line

C E L SE SW

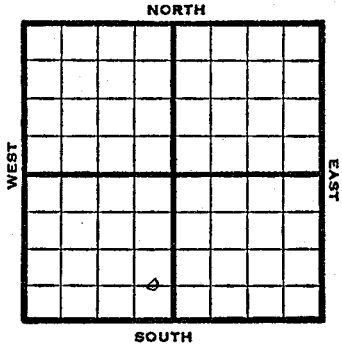

1950 Elev. 1667' REPORT

4/26 Spud 4-15-50
 8-5/8" @ 185'
 Lans. 2888'
 Cong. 3278'
 DST 3280-90
 Opn 30 min.
 Rec. 30' mud
 Miss 3299'
 TD 3310'
 DST 3299-3310
 Opn 1 hr
 Rec. 2 MCFG

6/14 8 5/8" @ 185
 Lans 2888
 Cong. 3278
 Arb. 3447-66
 5" @ 3466
 TD 3469
 2700' wtr.
 Set plug 3453
 Perf. 3436-38 HFW
 PB 3326
 137/3175-3215
 Comp. 1,000,000 gas
 Completed

COMPLETED