

Rice


KANSAS

DX 78-1

Section 8 Township 20 Range 9 W

Well No. #1 Coldwater

Company Bennett & Roberts

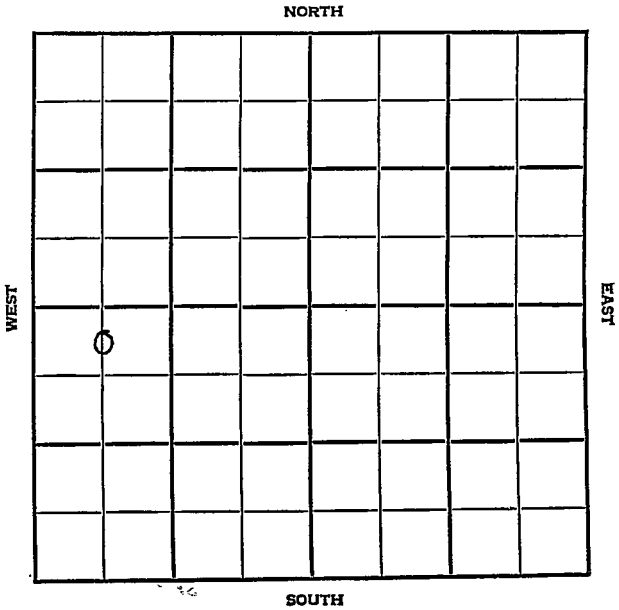

Rice

KANSAS


SEC.	8	TWP.	20	R.	9W
------	---	------	----	----	----

WELL NO. #1 Coldwater FARM

COMPANY Bennett & Roberts

CONTRACTOR Co. Tools

_____ Ft. from N. Line
 _____ Ft. from S. Line
 _____ Ft. from E. Line
 _____ Ft. from W. Line

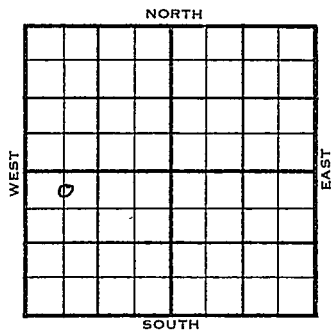

C N¹¹/₂ NW SW

	ELEVATION	REPORT
--	-----------	--------

1955	1738	
10/5	Comm 10-1-55 8" @ 212/135 Drlg 1220	
10/26	Comm 10-1-55 8" @ 212/135 5 1/2" @ 3253	
	H	2779
	Tr	2797
	Dg	2812
	BI	2907
	L	2930
	BKC	3203
	C	3223
	A	3253
	TD	3254
	DST 3025-34 open 1 hr rec 35' vso & gem 245/30" DD 3256 1000 A S/30 bo 60 bw 16 hr Comp 25 bopd 50 bw	

COMPLETED

County Hyce Elev. _____

Sec. 8 Twp. 20 Rge. 9W

Company Bennett & Roberts

Farm Name Coldwater No. 1

TOPS	DEPTH	LOG	DATUM	Loc. in Sec.
Anh.				<u>C N¹/₂ NW SW</u>
Tr.				
H.				
Dg.				
Bl.				
L.				Geol. _____
K.C.				Contr. _____
B.K.C.				<u>Co. tools</u>
Ce.				Pool _____
C.				
M.				
M.				
K.				
Mz.				
Mo.				
V.				
S.				
S.				
A.				
R.				
Pe.				
G.				
T.D.				

FIRST REPORT

OCT 5 '55

Date Comm. 10-1-55

8" @ 212/135 drlg. 1220

~~12~~

Co.

Lse.

No.

Sec.

T.

R.

County Rice Elev. 1738
 Sec. 8 Twp. 20 Rge. 9W
 Company Bennett & Roberts
 Farm Name Coldwater No. 1

TOPS	DEPTH	LOG	DATUM	Loc. in Sec.
Anh.				C N $\frac{1}{2}$ NW SW
Tr.				
H.	2779		1041	
Tr.		2797	1059	
Dg.		2812	1074	
Bl.	2907		1169	
L.	2930		1192	Geol.
K.C.				Contr.
B.K.C.	3203		1465	Co. tools
Ce.				Pool
C.	3223		1485	
M.				
M.				
K.				
Mz.				
Mq.				
V.				
S.				
S.				
A.	3253		1570	COMPLETE
R.				
PE.				
G.				
T.D.	3254			

Date Comm. 10-1-55 OCT 2 6 1955
8" @ 212/135 5 $\frac{1}{2}$ " @ 3253 DST 3025-34
open 1 hr. rec. 35' vso & g cm 245/30"
DD 3256 1000 A S/ 30 bo 60 bw 16 hr.
Comp. 25 bopd 50 bw

Co.
Lse.
No.
Sec.
T.
R.