


Section 8 Township 20 Range 9-W

Well No. #3 Proffitt

Company Phillips

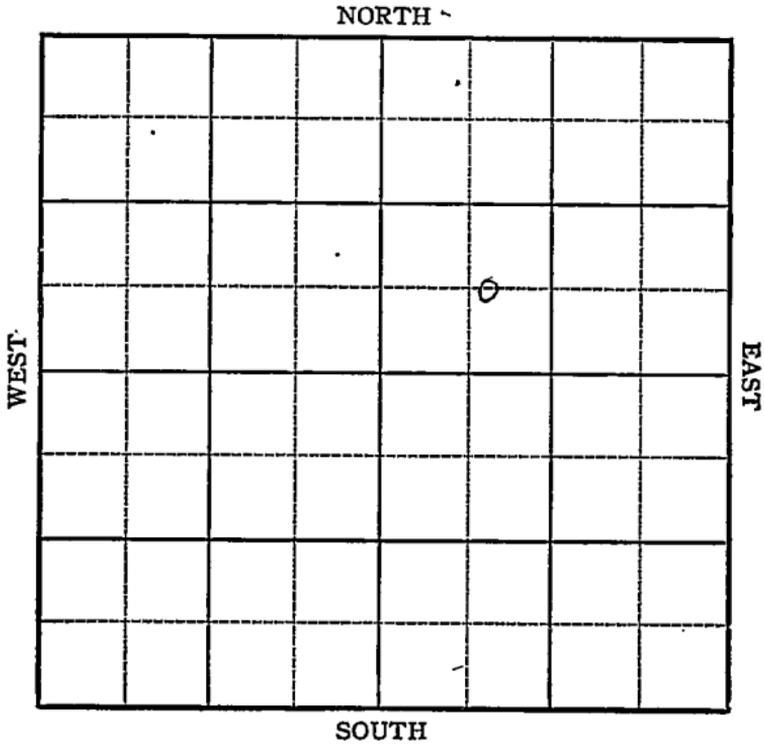

Sec. 8 Twp. 20 R. 9-W

Well No. #3 Proffitt Farm

Phillips Company


\_\_\_\_\_ Ft. from N. Line

660 Ft. from S. Line

\_\_\_\_\_ Ft. from E. Line

810 Ft. from W. Line

*Elev. 1730*

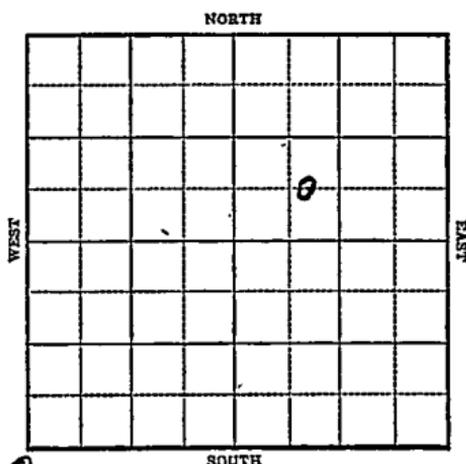

1943

R E P O R T

10/20 8" @ 269'  
W.O.C.

10/27 Drlg. 2692'

11/3 Arb 3222  
T.D. 3224  
5" @ 3222  
Rust

10/10 T.D. 3224-1700' oil

11/17 TD 3233  
swb 99 oil in 4 hrs.

11/24 500 Acid  
Pump 150 oil in 14 hrs.

12/1 " "

12/8 5" @ 3222  
Arb 3322  
2000 acid  
Pump 445 pot  
T.D. 3233  
Gravity 41.3

COMPLETED

KANSAS 19  
 Map No. 19 Sec. 8 Twp. 20 R. 9W

Well No. 3 Proffitt

Phillips Company

FIRST REPORT

Contractor

C SW NE.

SECTION PLAT

\_\_\_\_\_ Ft. from N. Line

660 Ft. from S. Line

\_\_\_\_\_ Ft. from E. Line

810 Ft. from W. Line

		o	

Chase Pool

Location \_\_\_\_\_

Rig up \_\_\_\_\_

Drilling and Remarks:

8" - 269 WOC

RECORD

Cased \_\_\_\_\_ in., \_\_\_\_\_ ft.

Sand \_\_\_\_\_

Gas \_\_\_\_\_

Oil \_\_\_\_\_

Total Depth \_\_\_\_\_

PRODUCTION

1st 24 hrs. Nat. \_\_\_\_\_

1st 24 hrs. after shot \_\_\_\_\_

Gas \_\_\_\_\_ Cu. Ft.

Dry Hole \_\_\_\_\_

Abandoned \_\_\_\_\_

Date

OCT 20 1943 19

S. J. LEWIS Scout

Rice

KANSAS

Map No. 49 Sec. 8 Twp. 20 R. 9W

Well No. 3 Proffitt

Phillips Company

COMPLETED Contractor

C SW NE

SECTION PLAT

		o	
		.	

\_\_\_\_\_ Ft. from N. Line

660 Ft. from S. Line

\_\_\_\_\_ Ft. from E. Line

810 Ft. from W. Line

Chase Pool

Location \_\_\_\_\_

Rig up \_\_\_\_\_

Drilling and Remarks:

*Ar 83222*  
*5' @ 3222*  
*2000 acid*  
*Pump 445 ft*  
  
*41 3/4*

RECORD

Cased \_\_\_\_\_ in., \_\_\_\_\_ ft.

Sand \_\_\_\_\_

Gas \_\_\_\_\_

Oil \_\_\_\_\_

Total Depth 3233

PRODUCTION

1st 24 hrs. Nat. \_\_\_\_\_

1st 24 hrs. after shot \_\_\_\_\_

Gas \_\_\_\_\_ Cu. Ft.

Dry Hole \_\_\_\_\_

Abandoned \_\_\_\_\_

Date

DEC 8 1943 19

S. J. LEWIS Scout