

Rice


KANSAS

Form 51-5M-11-38-Palace

Section 8 Township 20 Range 9-W

Well No. 1 Proffitt

Company Phillips

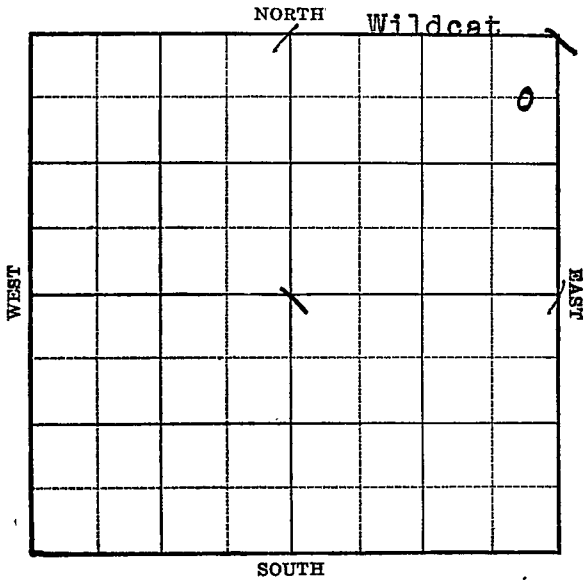

KANSAS


Rice

Sec. 8 Twp. 20 R. 9-WWell No. #1 Proffitt FarmPhillips Company

(Wildcat)

660 Ft. from N. Line Ft. from S. Line330 Ft. from E. Line Ft. from W. Line

Elev. 1725'

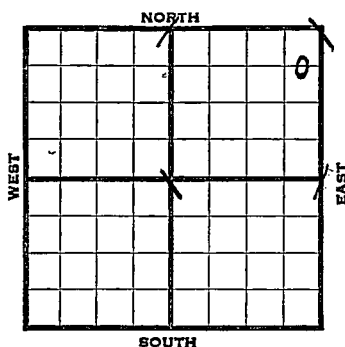

1939	REPORT
3/8	Location
3/17	R.U.R.
3/24	8" - 195' Drlg. 1787'
3/31	Lans. 2925' Drlg. 2945'
4/7	S.O. 3002-05' Cong. 3231'
	Simp. 3234' Arb. 3242'
	T.D. 3245' S.O. 5" - 3244'
4/14	T.D. 3259' 2700' oil.
	Swab 4½ oil per hour.
4/21	Shot 15 qts. 3253-59'
	Swab 123 oil in 9 hrs.
	Pump 59 oil in 8 hrs.
	Potential 177 bbls. May acidize
4/28	S.D.O.
5/5	1000 acid. Pump 77 oil 6 hrs.
	No water. Shut down 10 hrs.
	Pumped 21 oil, no water 4 hrs.
	Pumped off.
5/12	Pump 40 oil & 1/2 bbl. B.S. 7
	hours.
5/19	" " "

OVER

1939

5/24

Arb. 3242'

5" - 3244'

T.D. 3259'

Shot 15 qts. 3253-59'

1000 acid.

Pump 71 bbls. 8 hours.

Potential 212 oil & 27 water.

COMPLETED

Rice

KANSAS

Map No. 49 Sec. 8 Twp. 20 R. 9WWell No. 1 ProffittPhillips

Company

Contractor

FIRST REPORT

C E L N E N E

660 Ft. from N. Line


Ft. from S. Line

330 Ft. from E. Line

Ft. from W. Line

WILDCAT

SECTION PLAT

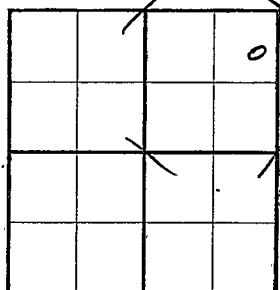Location X

Rig up

Drilling and Remarks:

RECORD

Cased _____ in., _____ ft.

Sand _____

Gas _____

Oil _____

Total Depth _____

PRODUCTION

1st 24 hrs. Nat. _____

1st 24 hrs. after shot _____

Gas _____ Cu. Ft.

Dry Hole _____

Abandoned _____

Date

MAR 8 - 1939 19

H. D. Hatfield Scout

Rice

Map No. 49 Sec. 8 Twp. 20 R. 9WWell No. 1 ProffittPhillips

Company

Contractor

COMPLETED


SECTION PLAT

660 **C E L N E N E**
Ft. from N. Line

Ft. from S. Line

330 Ft. from E. Line

Ft. from W. Line

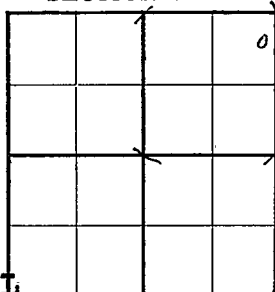

GOLDWATER NORTH POOL

Location _____

RECORD

Cased _____ in., _____ ft.

Sand _____

Gas _____

Oil _____

Total Depth 3259

PRODUCTION

1st 24 hrs. Nat. _____

1st 24 hrs. after shot _____

Gas _____ Cu. Ft.

Dry Hole _____

Abandoned _____

Rig up _____

Drilling and Remarks:

*Cr & 3242.**5" C 3244.**Shot 159 to 3253-59**1000 acid**Pump - 71 - 8 hrs.**Prod 212 oil 27 Water*

Date

MAY 24 1939 19

S. J. LEWIS

Scout