


Section 8 Township 20 Range 9-W

Well Number 1-Sharp

Company Magnolia

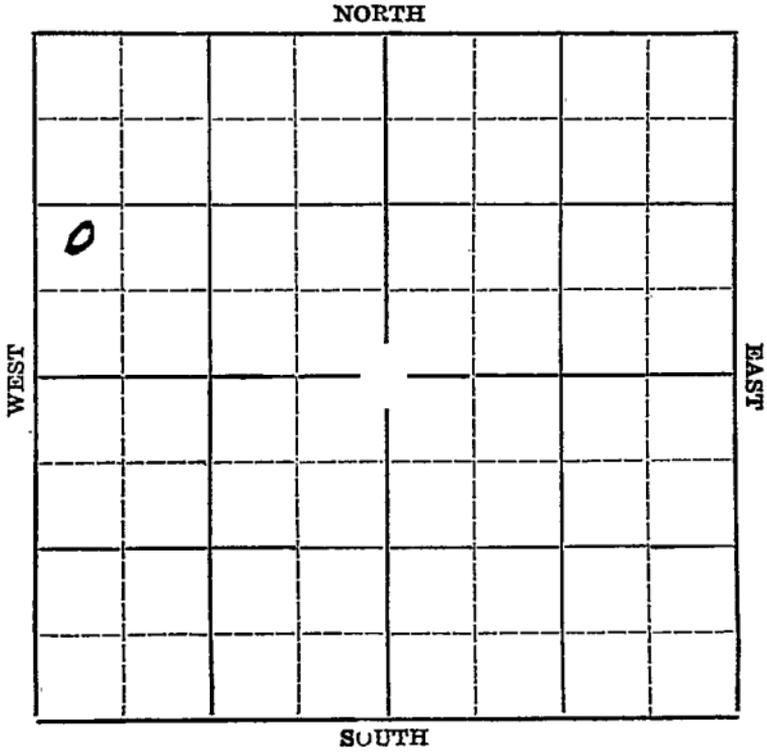

Map No. KANSAS Sec. 8 Twp. 20 R. 9W

Well No. #1 Sharp Farm


Magnolia Company

_____ Ft. from N. Line

990' Ft. from S. Line

_____ Ft. from E. Line

330' Ft. from W. Line

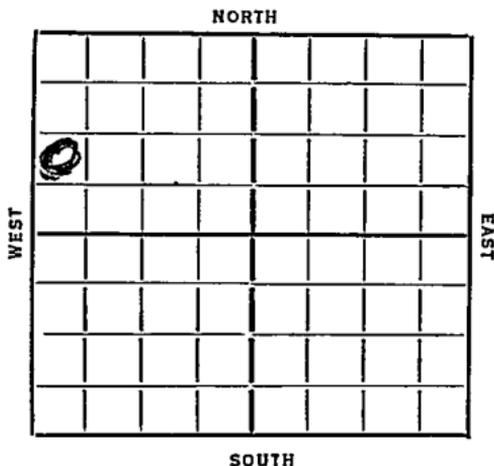

Date
1936

REPORT

6/10 Rig.

6/18 -- 6/25--

7/2 Drlg. 2625'.

7/9 Sil. 3257'. Set 7" @ T.D. 3259&.

7/16 T.D. 3281'. Swabb 2 bbls of oil per hour. 1000 gallons of acid.

No test.

7/23 Shut down at 3304'.

7/30 TD 3308'. 1 bailer of water. PB to 3300'. Shot 24 qts. 2000 gallon of acid. Testing.

8/6 P.B. 3288'. Cleaning out.

8/13--

8/19/36 Sil. 3257'.

T.D. 3308'.

Shot 24 qts.

4000 gallons of acid.

Pump 42 bbls of oil. 774 bbls of water in 24 hours.

Dry and abandoned.

ABANDONED

Map No. 49 Sec. 8 Twp. 20 R. 9WWell No. 1 SharpMagnolia Company

Contractor

SECTION PLAT

0			

_____ Ft. from N. Line

990 Ft. from S. Line

_____ Ft. from E. Line

330 Ft. from W. Line

FIRST REPORT

Location _____

Rig up _____

Drilling and Remarks:

Rig

RECORD

Cased _____ in., _____ ft.

Sand _____

Gas _____

Oil _____

Total Depth _____

PRODUCTION

1st 24 hrs. Nat. _____

1st 24 hrs. after shot _____

Gas _____ Cu. Ft.

Dry Hole _____

Abandoned _____

Date

JUN 10 1936

19

S. J. LEWIS

Scout

KANSAS

Map No. 49 Sec. 8 Twp. 20 R. 9W.

Well No. 1 Sharp

Morgania Company

Contractor

SECTION PLAT

0			

_____ Ft. from N. Line

990 Ft. from S. Line

_____ Ft. from E. Line

330 Ft. from W. Line

ABANDONED

Location _____

Rig up _____

Drilling and Remarks:

*Oil 3257
Shot 249 to
4000 acid
Pump 42 oil 774
water 24 hrs
J & H*

RECORD

Cased _____ in., _____ ft.

Sand _____

Gas _____

Oil _____

Total Depth 3305

PRODUCTION

1st 24 hrs. Nat. _____

1st 24 hrs. after shot _____

Gas _____ Cu. Ft.

Dry Hole _____

Abandoned _____

Date

AUG 19 1936

19

S. J. LEWIS Scout