


Section 8 Township 20 Range 9-W

Well No. ~~#3~~ ^{#2} Coldwater "A"

Company Cities Service Oil

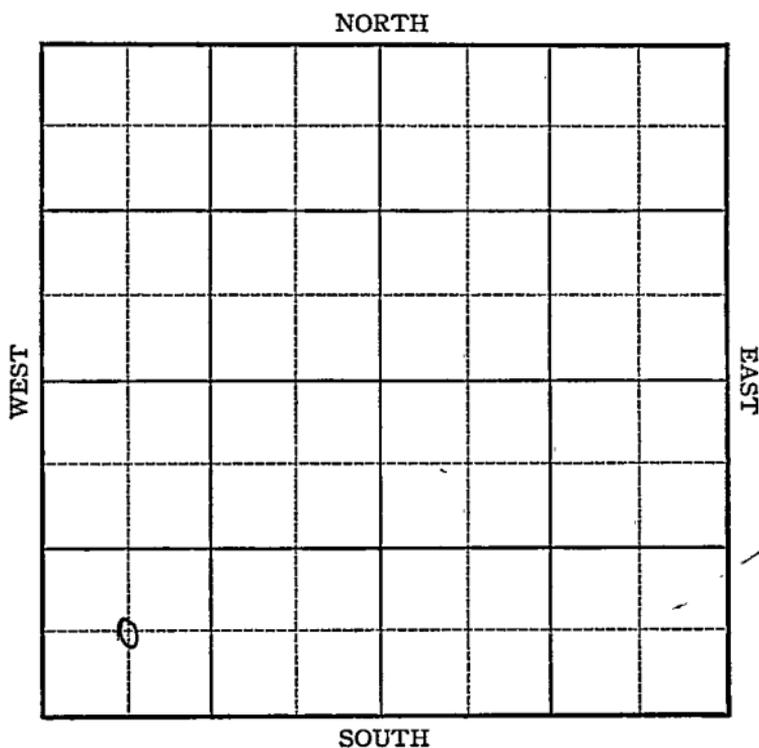

Sec. 8 Twp. 20 R. 9-W

Well No. #2
#3 Coldwater "A" Farm

Cities Service Oil Company


_____ Ft. from N. Line

660 Ft. from S. Line

_____ Ft. from E. Line

660 Ft. from W. Line

3000 - 1744

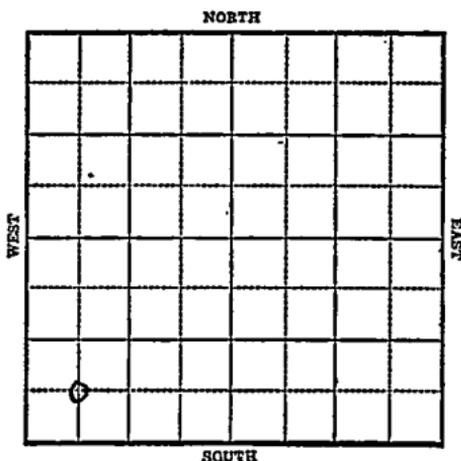

1943

R E P O R T

5/19

8" - 191'
Waiting on cement.

5/26

Drlg. 3225

6/2

Mans 2956
Aro 3266
Sat 3269-71 T.D.
5" @ 3268 RUST

6/9

T.D. 3270
Arb 3359 Corrected
5" @ 3261
T.D. 3270-103 oil & 68 water PB

6/16

T.D. 3271-1000 acid
Pump 11 oil & 33 water in 5 hrs.

6/23

2000 acid pump 30 oil 57 water
in 8 hrs.

6/30

" "

7/7

" "

7/14

Arb. 3259
5" @ 3261'
T.D. 3271'
3000 gal. acid
Pump 103 oil plus 68 water Pot.
Gravity 43.2

COMPLETED

Rice

KANSAS / 9 Map No. Sec. 8 Twp. 20 R. 9W

Well No. 3 Coldwater "A"

Cities Service Oil Company

FIRST REPORT

Contractor

C S W S W

_____ Ft. from N. Line

660 Ft. from S. Line

_____ Ft. from E. Line

660 Ft. from W. Line

SECTION PLAT

o			

CHASE POOL

Location _____

Rig up _____

Drilling and Remarks:

8"-191'

Waiting on
cement

RECORD

Cased _____ in., _____ ft.

Sand _____

Gas _____

Oil _____

Total Depth _____

PRODUCTION

1st 24 hrs. Nat. _____

1st 24 hrs. after shot _____

Gas _____ Cu. Ft.

Dry Hole _____

Abandoned _____

Date

MAY 1 9 1943

S. J. LEWIS

Scout

KANSAS

Map No. 20 Sec. 8 Twp. 20 R. 9WWell No. 2 Coldwater "A"

Cities Service Oil Company

CORRECTION Contractor

C SW SW

SECTION PLAT

 Ft. from N. Line660 Ft. from S. Line Ft. from E. Line660 Ft. from W. Line

0			

CHASE POOL

Location Rig up

Drilling and Remarks:

Reported as #3

RECORD

Cased in., ft.Sand Gas Oil Total Depth

PRODUCTION

1st 24 hrs. Nat. 1st 24 hrs. after shot Gas Cu. Ft.Dry Hole Abandoned

Date

JUN 9 1943 19

S. J. LEWIS Scout

Rice

KANSAS

Map No. 419 Sec. 8 Twp. 20 R. 9W

Well No. 2 Coldwater "A"

Cities Service Oil Company

COMPLETED

Contractor

C SW SW

SECTION PLAT

_____ Ft. from N. Line

660 Ft. from S. Line

_____ Ft. from E. Line

660 Ft. from W. Line

o			

CHASE POOL

Location _____

Rig up _____

Drilling and Remarks:

CR 83259
5-11 @ 3261
3000 acil
Pump 103 oil
+ 65 Water
432/yr

RECORD

Cased _____ in., _____ ft.

Sand _____

Gas _____

Oil _____

Total Depth 3271

PRODUCTION

1st 24 hrs. Nat. _____

1st 24 hrs. after shot _____

Gas _____ Cu. Ft.

Dry Hole _____

Abandoned _____

Date

JUL 14 1943 19

S. J. LEWIS Scout