

# KANSAS

Rice


FORM 51 5M 4-41 PETROL

Section 8 Township 20 Range 9-W

Well No. #2 Proffitt

Company Phillips

NORTH Keesling Pool

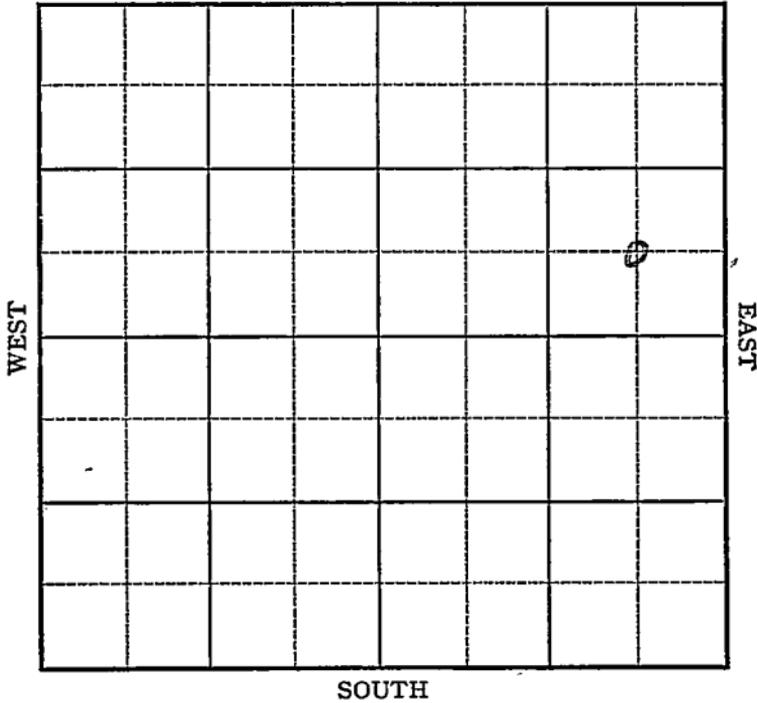



Rice

KANSAS

Map No. 49 Sec. 8 Twp. 20 R. 9WWell No. 2 ProffittPhillips CompanyCOMPLETED Contractor

C SE NE

## SECTION PLAT

         Ft. from N. Line660 Ft. from S. Line660 Ft. from E. Line         Ft. from W. Line

			o

KEESLING POOLLocation                                 Rig up                                 

Drilling and Remarks:

*Ar 83246**5" @ 3246**2000 and 1**Pump 174 P.T.**H. S. G.*

## RECORD

Cased          in.,          ft.Sand                                 Gas                                 Oil                                 Total Depth 3255 1/2

## PRODUCTION

1st 24 hrs. Nat.                         1st 24 hrs. after shot                         Gas                                  Cu. Ft.Dry Hole                                 Abandoned                                 

Date

JUL 22 1942 19S. J. LEWIS Scout

Map No. 49 Sec. 8 Twp. 20 R. 9WWell No. 2 Proffitt

Phillips

Company

**FIRST REPORT**

Contractor

## SECTION PLAT

C SE NE

\_\_\_\_\_ Ft. from N. Line

660 Ft. from S. Line660 Ft. from E. Line

\_\_\_\_\_ Ft. from W. Line

			o

KEESLING POOL

Location XXX

Rig up \_\_\_\_\_

Drilling and Remarks:

## RECORD

Cased \_\_\_\_\_ in., \_\_\_\_\_ ft.

Sand \_\_\_\_\_

Gas \_\_\_\_\_

Oil \_\_\_\_\_

Total Depth \_\_\_\_\_

## PRODUCTION

1st 24 hrs. Nat. \_\_\_\_\_

1st 24 hrs. after shot \_\_\_\_\_

Gas \_\_\_\_\_ Cu. Ft.

Dry Hole \_\_\_\_\_

Abandoned \_\_\_\_\_

Date

JUN 10 1942

19

S. J. LEWIS  
Scout