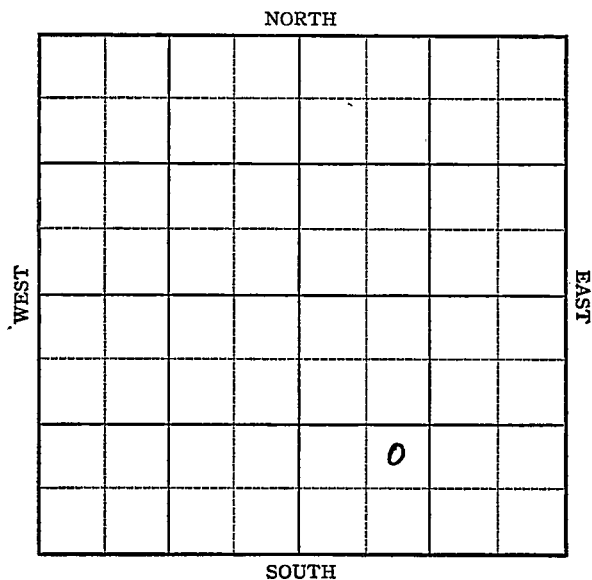


Section 8 Township 20 Range 9-WWell No. #2 YoungCompany Cities Service Oil

KANSAS

Rice

Sec. 8 Twp. 20 R. 9-W

Well No. #2 Young _____ Farm _____

Cities Service Oil _____ Company

(Keesling).


Ft. from N. Line

990 Ft. from S. Line

Ft. from E. Line

990 Ft. from W. Line

Elev. 1729

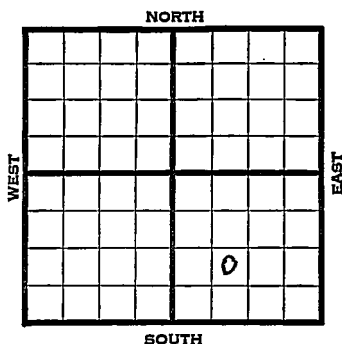

1941	REPORT
11/25	Location
12/4	"
12/11	8" @ 255 Drlg. 2150
12/18	Arb. 3244 TD 3248
	5" @ 3246 RUST
12/24	T.D. 3255' 3000' oil.
12/31	2000 acid. Swab 33 oil 2½ hrs.
1942	
1/8	" " " "
1/15	" " " "
1/21	Arb. 3244'
	5" - 3246'
	T.D. 3255'
	2000 acid.
	Echometer potential 591 bbls.
	44.5 Gravity
	COMPLETED

Rice

KANSASMap No. H 49 Sec. 8 Twp. 20 R. 9WWell No. 2 YoungCities Service Oil CompanyFIRST REPORT Contractor

NE SW SE

SECTION PLAT

 Ft. from N. Line990 Ft. from S. Line Ft. from E. Line990 Ft. from W. Line

KEESLING POOL

Location XXRig up

Drilling and Remarks:

RECORD

Cased in., ft.Sand Gas Oil Total Depth

PRODUCTION

1st 24 hrs. Nat. 1st 24 hrs. after shot Gas Cu. Ft.Dry Hole Abandoned

Date

NOV 25 1941

19

S. J. LEWIS Scout

Rice

KANSAS

Map No. 49 Sec. 8 Twp. 20 R. 9WWell No. 2 YoungCities Service Oil CompanyCOMPLETED Contractor

NE SW SE

 Ft. from N. Line990 Ft. from S. Line Ft. from E. Line990 Ft. from W. Line

SECTION PLAT

KEESLING POOL

RECORD

Location Cased in., ft.Rig up Sand

Drilling and Remarks:

Gas *Cr & 3244*Oil *5" @ 3246*Total Depth 3255*2000 @ 3246**Ech & 3259*

PRODUCTION

1st 24 hrs. Nat. 1st 24 hrs. after shot Gas Cu. Ft.Dry Hole Abandoned

Date

JAN 21 1942

19

S. J. LEWIS Scout