

KANSAS

FORM 51 5M BRIX

Section 8 Township 20 Range 9W

Well No. 3 Sharpe

Company Skelly

NORTH

WEST

EAST

SOUTH

KANSAS

Rice

Sec. 8 Twp. 20 R. 9W

Well No. #3 Sharpe Farm

Skelly Company


Silica

990 Ft. from N. Line

Ft. from S. Line

330 Ft. from E. Line

Ft. from W. Line

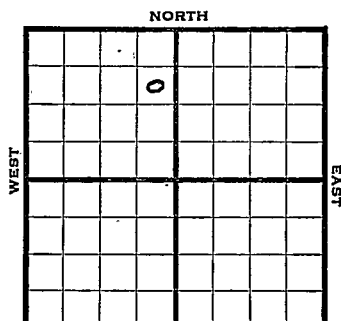

SOUTH
SE NE NW

Edw. 1728

1944

REPORT

8/30

Derrick

9/8

8" @ 215 WOU

9/13

Drlg. 2770

9/21

Lans 2920

Arb 3234

TD 3238 SSO

5" @ 3235 RUST

9/28

TD 3269

500 acid swb 1 oil plus 10 wtr in 4hrs

10/4

Arb 3234

5" @ 3235

500 acid

Pump 53 pot.

TD 3275

Grav. 42.3

COMPLETED

Pool Name SilicaKANSASMap No. 29 Sec. 8 Twp. 20 R. 9WWell No. 3 SharpeSkelly Company

FIRST REPORT

Contractor

SE NE NW

SECTION PLAT

990 Ft. from N. Line Ft. from S. Line330 Ft. from E. Line Ft. from W. Line

Rice County

Location Rig up

Drilling and Remarks:

Derrick

RECORD

Cased in., ft.Sand Gas Oil Total Depth

PRODUCTION

1st 24 hrs. Nat. 1st 24 hrs. after shot Gas Cu. Ft.Dry Hole Abandoned

Date

AUG 30 1944


19

S. J. LEWIS Scout

Pool Name SilicaMap No. 49 Sec. 8 Twp. 20 R. 9WWell No. 3 SharpeSkelly CompanyCOMPLETED Contractor

SE NE NW

SECTION PLAT

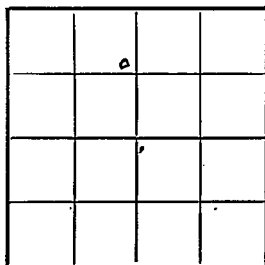990 Ft. from N. Line Ft. from S. Line330 Ft. from E. Line Ft. from W. LineRice CountyLocation Rig up

Drilling and Remarks:

Ar 8234
5-103235
500 acid
Pump 5328

4238

RECORD

Cased in. ft.Sand Gas Oil Total Depth 3225

PRODUCTION

1st 24 hrs. Nat. 1st 24 hrs. after shot Gas Cu. Ft.Dry Hole Abandoned

Date

OCT 4 1944 19S. J. LEWIS Scout