


Section 8 Township 20 Range 9-W

Well No. #4 Young

Company Cities Service Oil

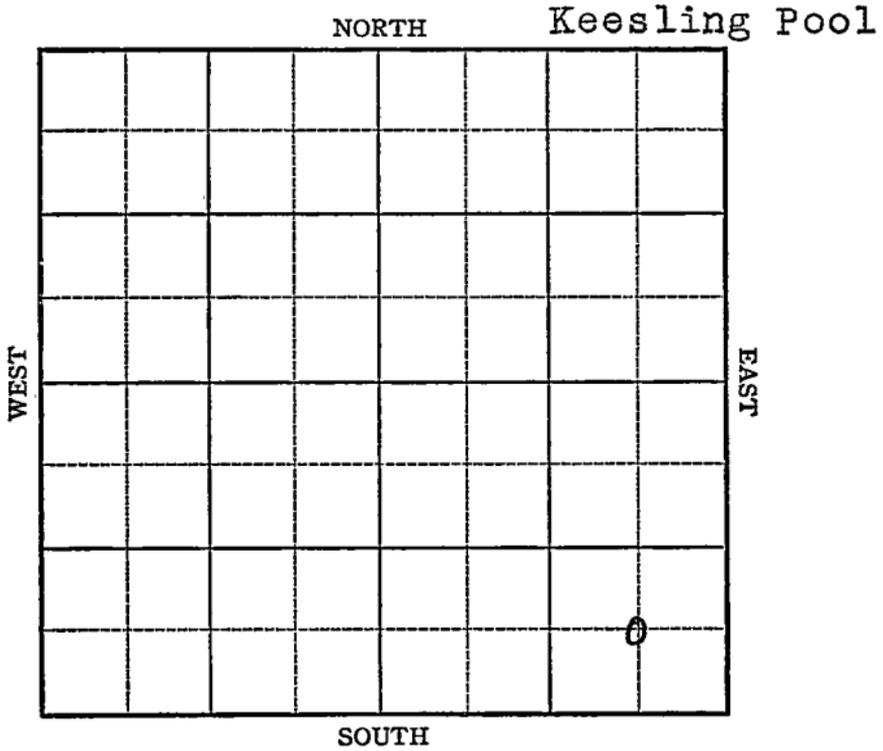

Sec. 8 Twp. 20 R. 9-W

Well No. #4 Young Farm

Cities Service Oil

Company

(Keesling)


_____ Ft. from N. Line

660 Ft. from S. Line

660 Ft. from E. Line

_____ Ft. from W. Line

Elev. 1739

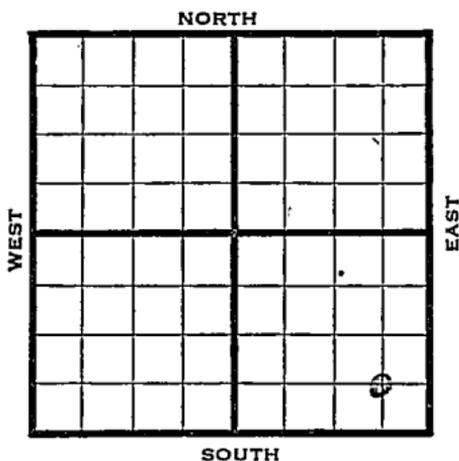

1942

REPORT

7/1	8-5/8" - 233' WOCe
7/8	Shut down.
7/15	Drlg. 1755'
7/22	Arb. 3273-79 T.D. 5" @ 3275 RUST
7/29	TD 3289 1900 acid.
8/5	Arb. 3273 5" - 3275' TD 3287' Pump 635 Pot. Gravity 44.5

COMPLETED

Map No. 49 Sec. 8 Twp. 20 R. 9W

Well No. 4 Young

Cities Service Oil Company

FIRST REPORT

Contractor

C SE SE

SECTION PLAT

_____ Ft. from N. Line

660 Ft. from S. Line

660 Ft. from E. Line

_____ Ft. from W. Line

			o

KEESLING POOL

Location _____

Rig up _____

Drilling and Remarks:

8 5/8" - 233'

Waiting on
cement

RECORD

Cased _____ in., _____ ft.

Sand _____

Gas _____

Oil _____

Total Depth _____

PRODUCTION

1st 24 hrs. Nat. _____

1st 24 hrs. after shot _____

Gas _____ Cu. Ft.

Dry Hole _____

Abandoned _____

Date

JUL 1 1942 19

S. J. LEWIS

Scout

Rice

Map No. 49 Sec. 8 Twp. 20 R. 9W

Well No. 4 Young

Cities Service Company

COMPLETED Contractor

C S E S E

SECTION PLAT

_____ Ft. from N. Line

660 Ft. from S. Line

660 Ft. from E. Line

_____ Ft. from W. Line

			0

KEESLING P OOL

Location _____

Rig up _____

Drilling and Remarks:

*Oil 3229
5" @ 3275.*

Pump 635 P.O.Y.

44 5/8"

RECORD

Cased _____ in., _____ ft.

Sand _____

Gas _____

Oil _____

Total Depth 3287

PRODUCTION

1st 24 hrs. Nat. _____

1st 24 hrs. after shot _____

Gas _____ Cu. Ft.

Dry Hole _____

Abandoned _____

Date

AUG 5 1942 19

S. J. LEWIS Scout